


City of Elkhart

S.R.19 CORRIDOR IMPROVEMENTS - REBID (PA7663)

SECTION 20, TOWNSHIP 38 NORTH, RANGE 5 EAST, OSOLO TOWNSHIP, ELKHART COUNTY, INDIANA

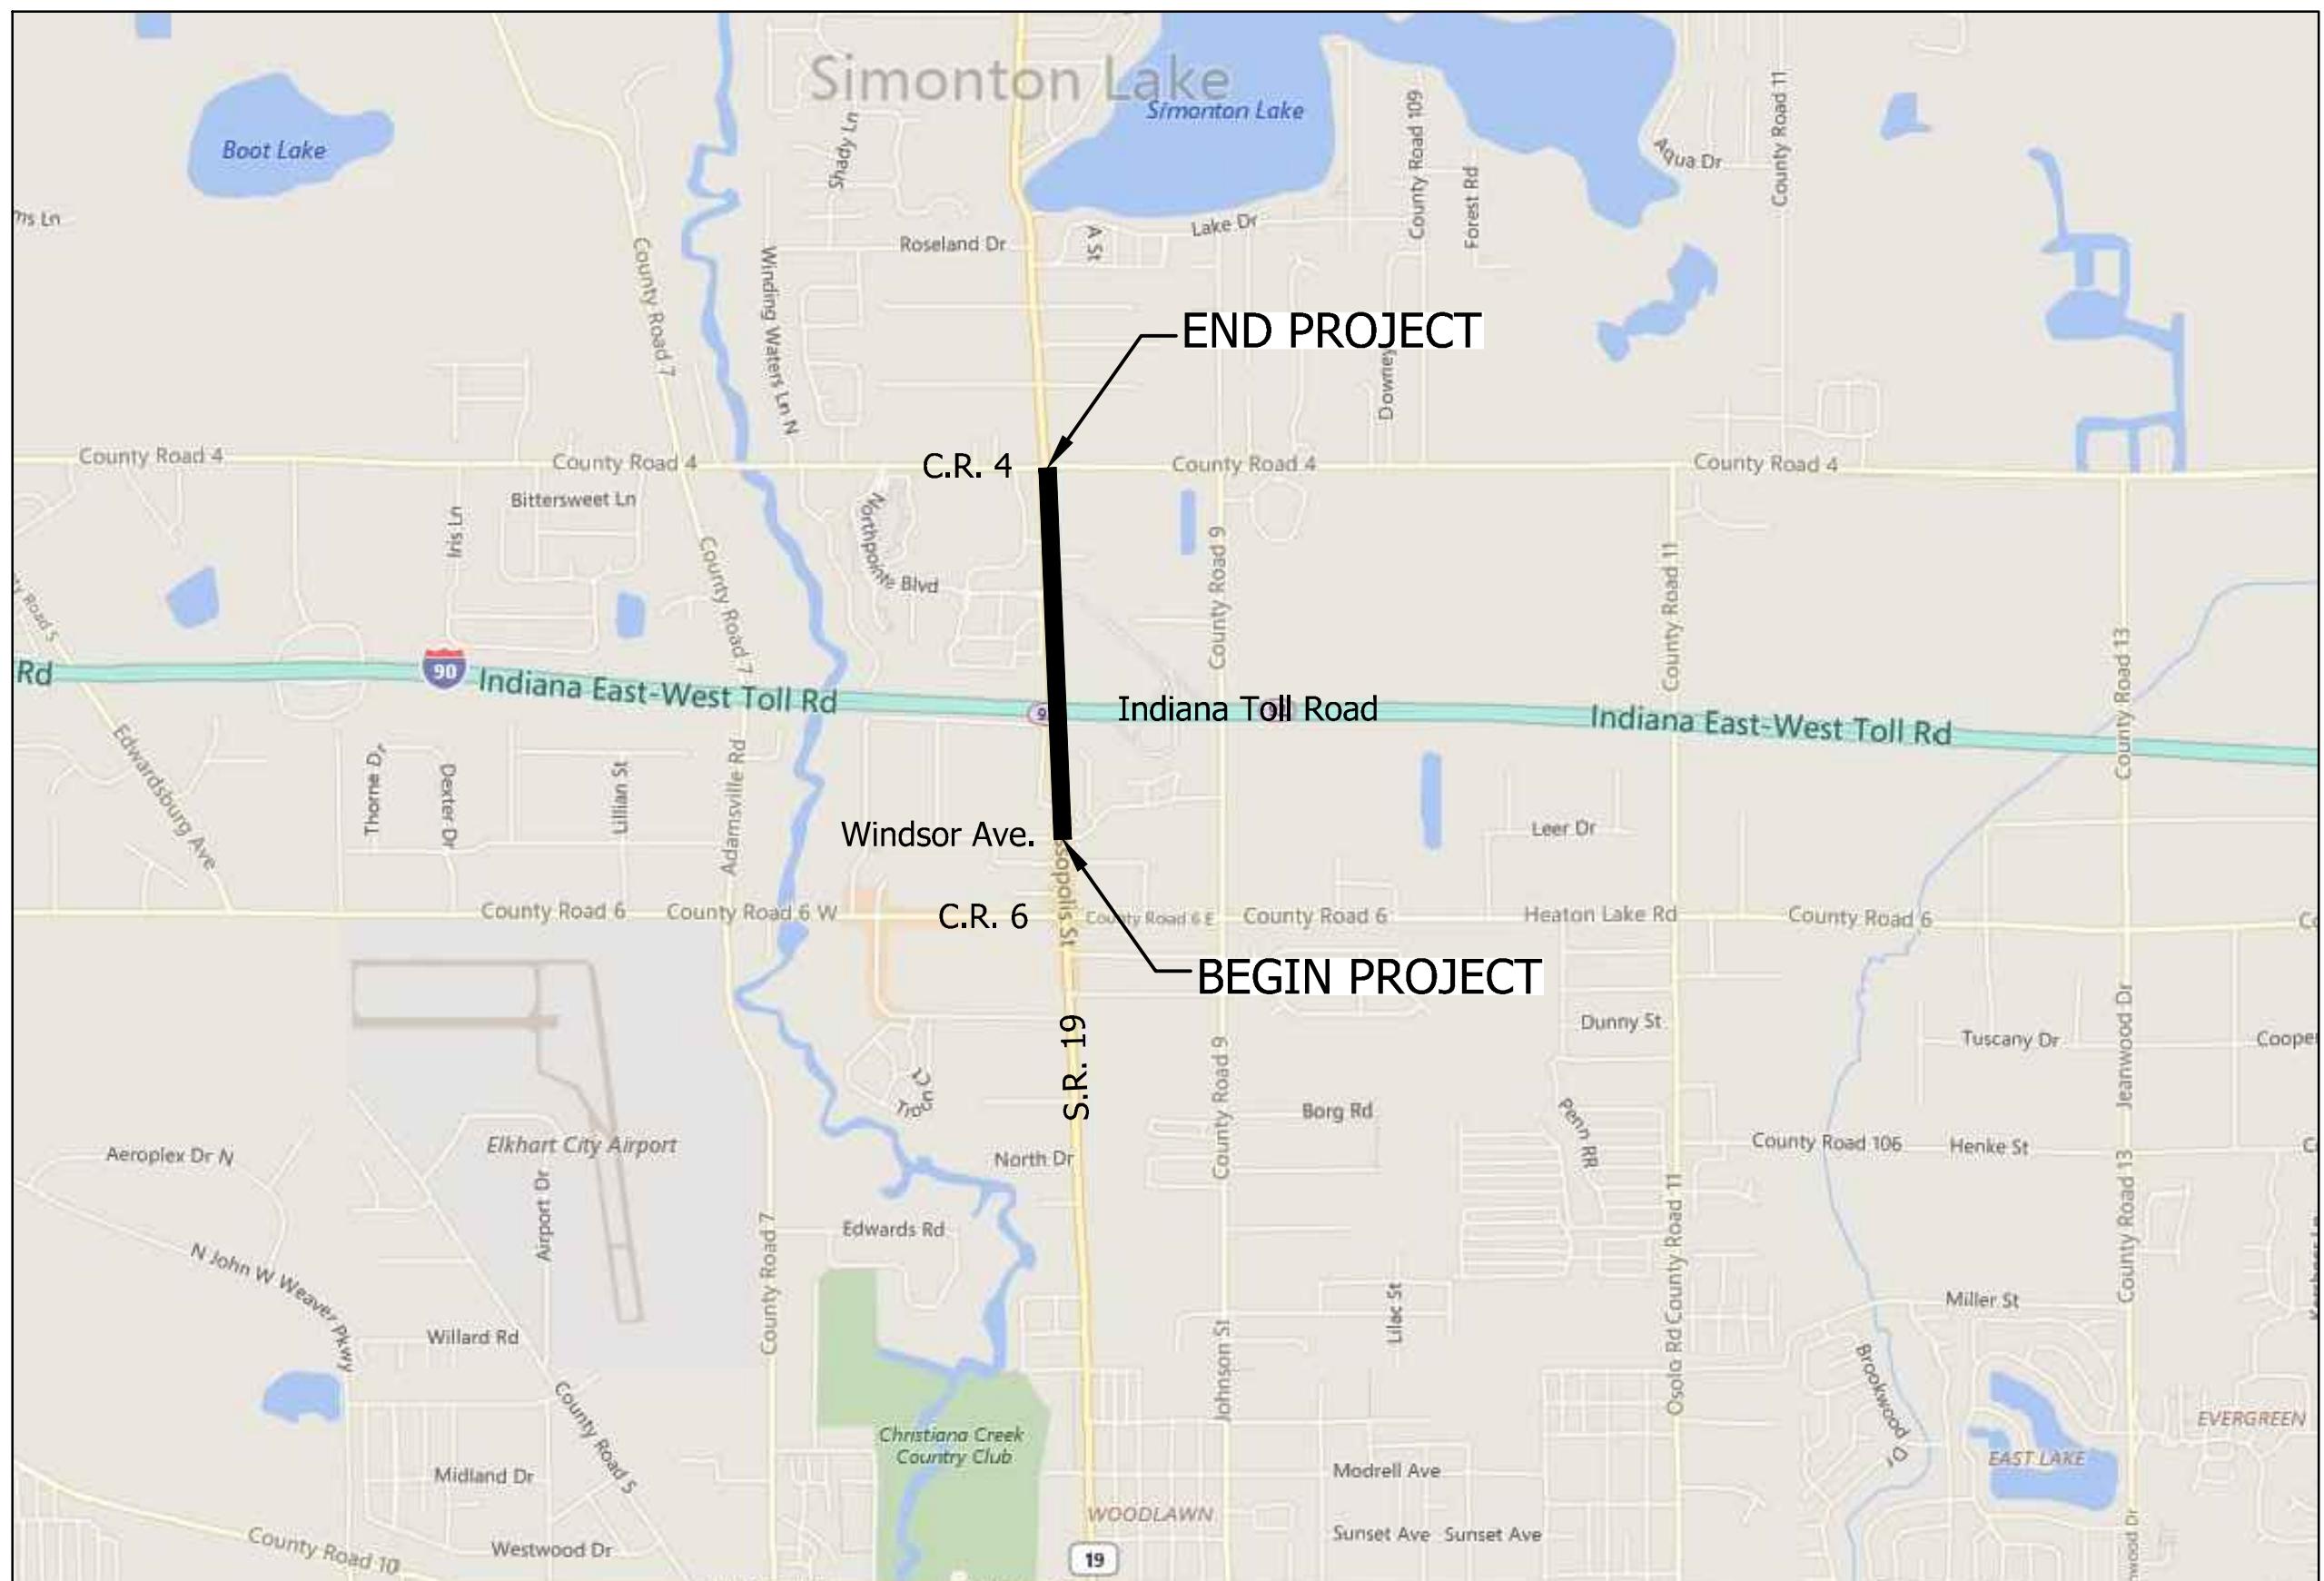

APPROVED BY
BOARD OF PUBLIC WORKS

PROJECT:		DATE
MICHAEL C. MACHLAN	PRESIDENT	
CHAD CRABTREE	VICE-PRESIDENT	
JAMIE ARCE	MEMBER	
RONNIE DAVIS	MEMBER	
ROSE RIVERA	MEMBER	

STATE ROAD 19
CORRIDOR IMPROVEMENTS
(PA7663)

COVER SHEET
& INDEX

SHEET INDEX	
Sheet Number	Sheet Title
1	Cover Sheet & Index
2-3	Typical Sections
4-7A	Maintenance of Traffic
8-12	Site Plan
13-17	Grading Plan w/ Layout and Grading Details 1 & 2
18-21	Layout and Grading Details 3-6: Placemaking Nodes
22-23	Layout and Grading Details 7A & 7B: Linear Park
24	Layout and Grading Detail 8: S.R. 19/ C.R. 4 Intersection
25-27	Layout and Grading Details: Drive Approaches
28-32	Landscape Plan
33	Landscape Details
34	Lighting Plan
35-39	Retaining Wall Structural Plans
40	Typical Wall Elevations & Monument Sign Details
41-45	Retaining Wall Sections & Details
46-47	Steel Details
48	General Structural Notes
49-51	Site Construction Details
52-56	Erosion Control Plans

SURVEYOR/CIVIL ENGINEER
Abonmarche Consultants, Inc.

315 West Jefferson Boulevard
South Bend, IN 46601
(574) 232-8700


DRAWN BY:
NI
DESIGNED BY:
CAK/ZDH
PM REVIEW:
RAN
QA/QC REVIEW:
DSK
DATE:
03/02/23

SEAL:


SIGNATURE:

DATE:
03/02/2023
SCALE:
HORZ: AS SHOWN
VERT: N/A
ACI JOB #
20-1114
SHEET NO.
1 of 56


1.	REV. MOT: REV. LIMESTONE VENEER; REV. MEDIAN LANDSCAPING	NI	07/17/23
NO.	REVISION DESCRIPTION	BY	DATE

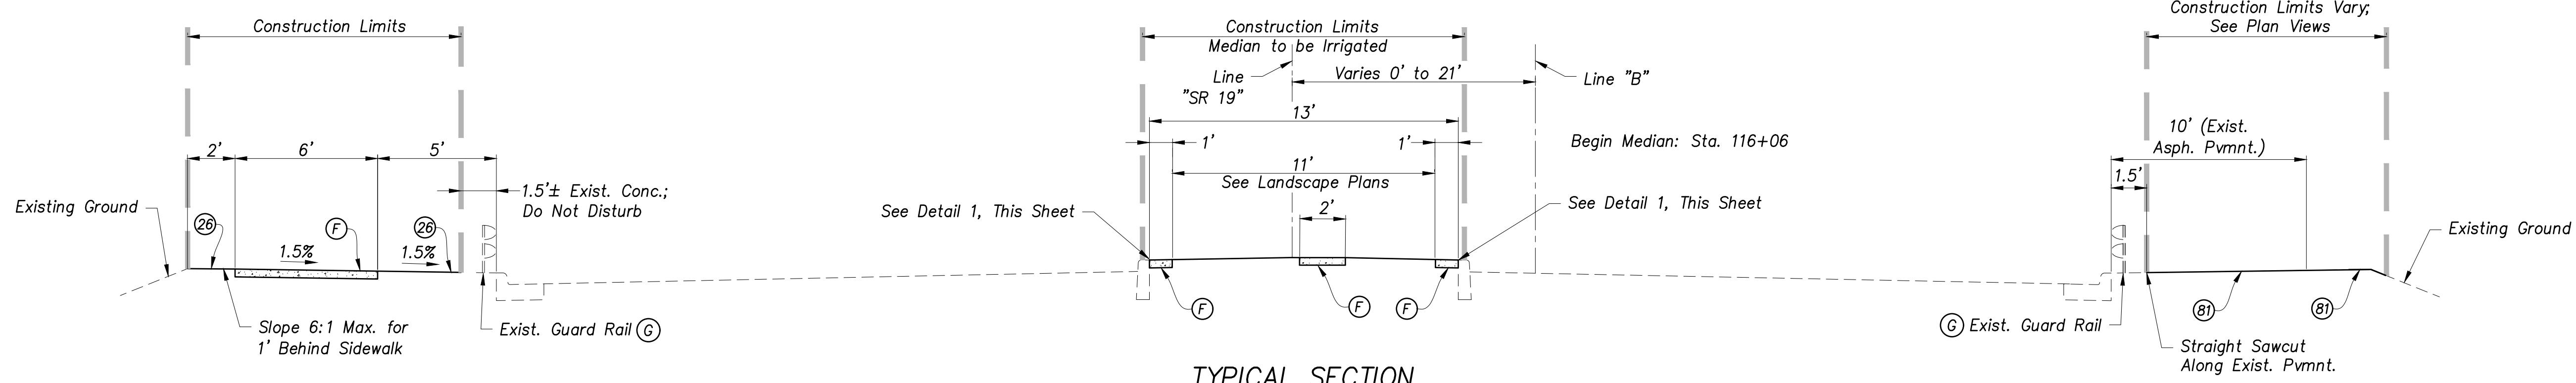

TYPICAL SECTION
Sta. 114+51 to Sta. 123+77, Line "B"
 Horiz. & Vert. Scale: 1" = 4'

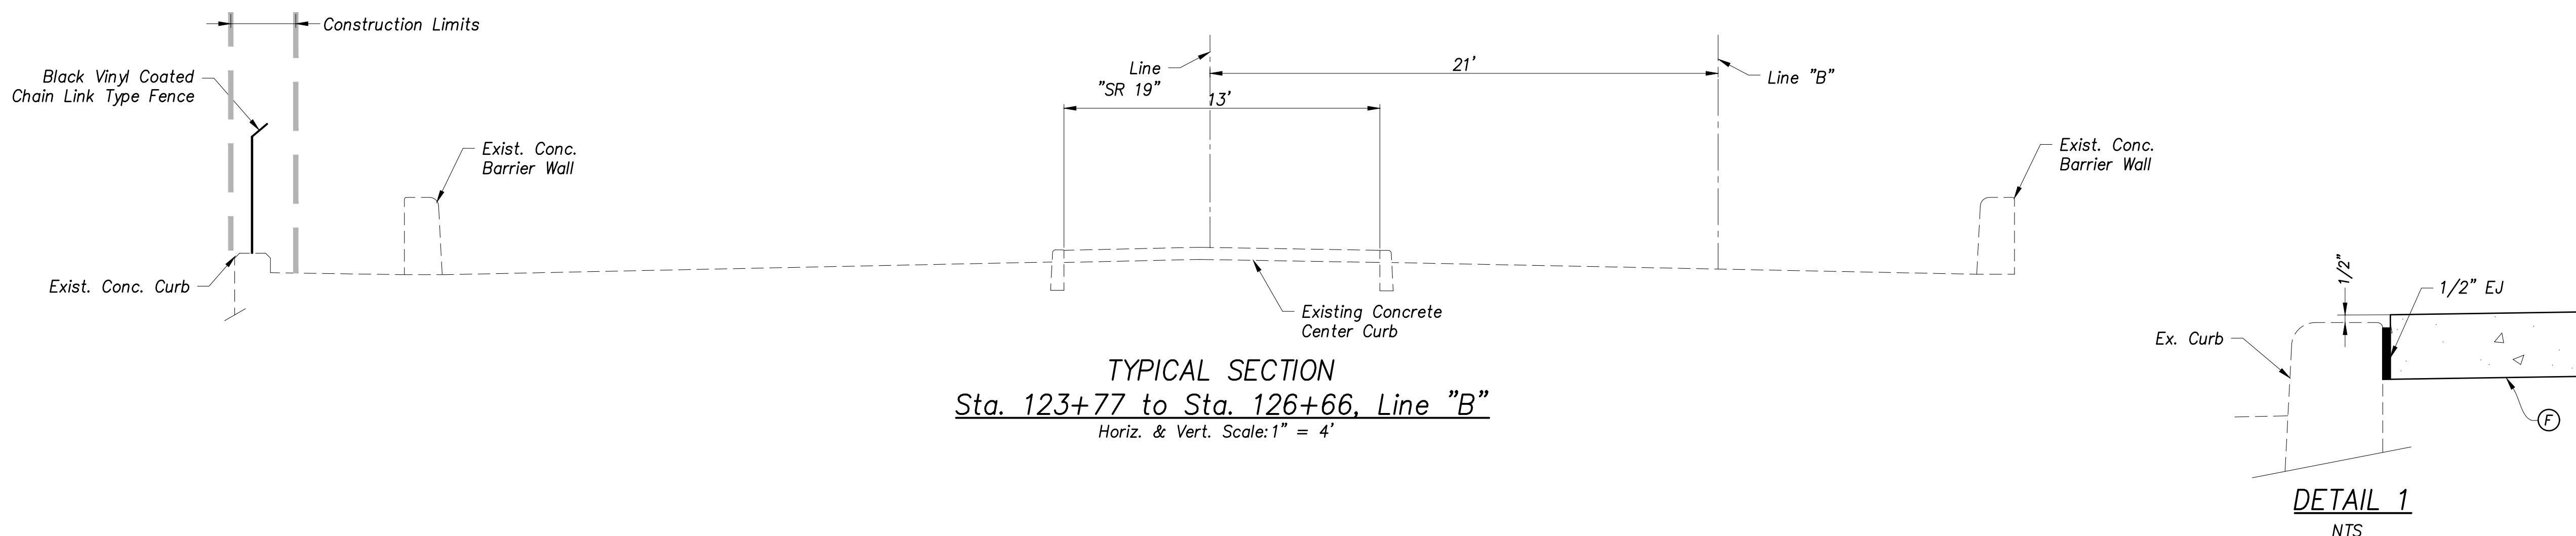

TYPICAL SECTION
Sta. 123+77 to Sta. 126+66, Line "B"
Horiz. & Vert. Scale: 1" = 4'

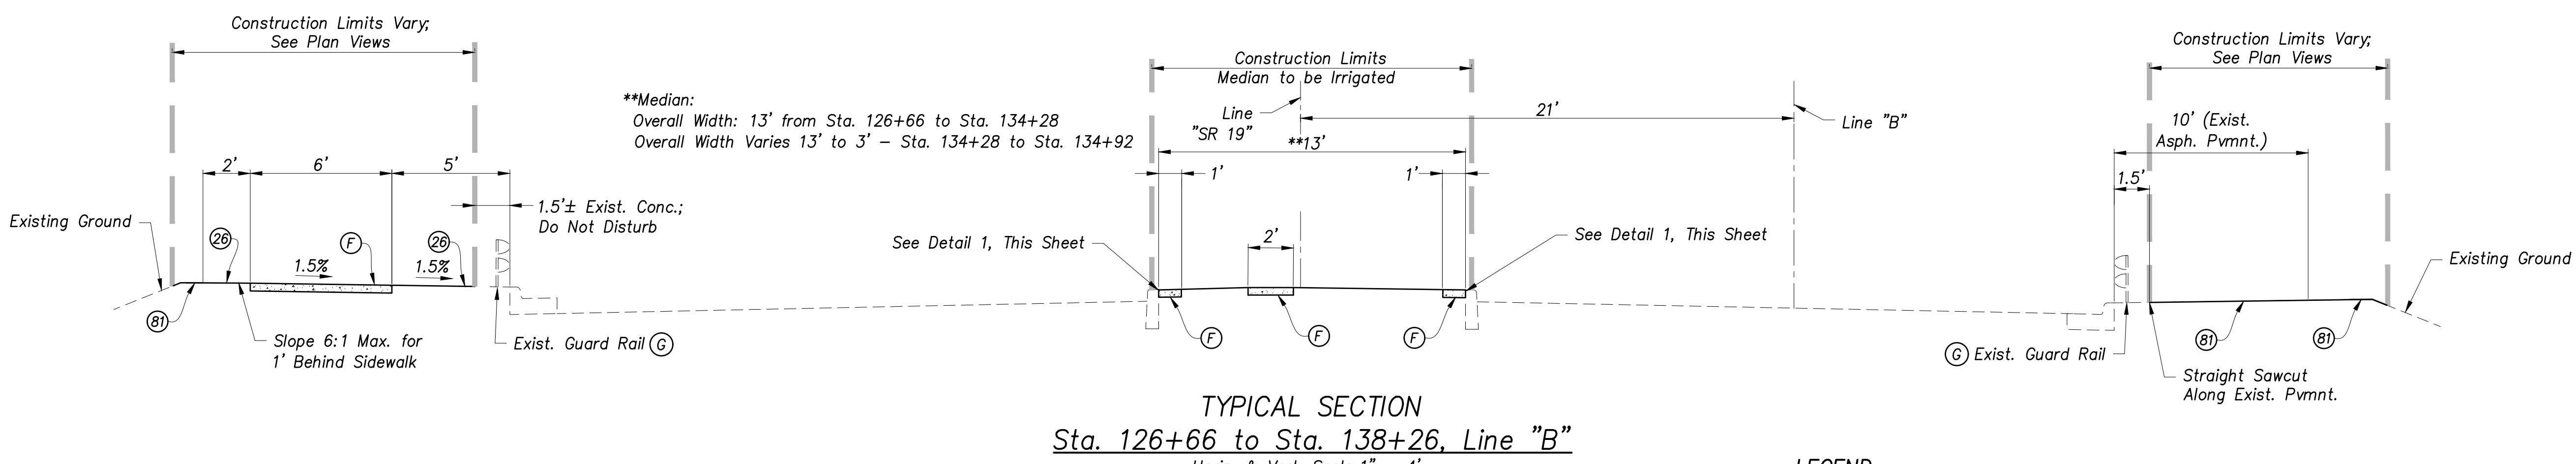

NOTES

1. Slope median perimeter concrete maintenance strip 1.5% upward from the existing top of curb.
 2. Median interior concrete maintenance path shall be flat with a finished elevation matching the back of the closest perimeter maintenance strip.

LEGEND

- (F) Concrete Sidewalk, 4"
 - (G) Clean & Paint
Existing Guard Rail Black
 - (26) Sodding
 - (81) Mulched Seeding,
Type "U"


ABONMARCHÉ

15 W. Jefferson Blvd.
Portage, MI 49024
(269) 323-1222


Benton Harbor
El. Wayne

South Bend


Engineering • Architecture • Land Surveying
COPYRIGHT 2020 - ABONNARCHE CONSULTANTS, INC.
South Haven
Valparaiso
Goshen
Hobart
Lafayette
abonnarche.com

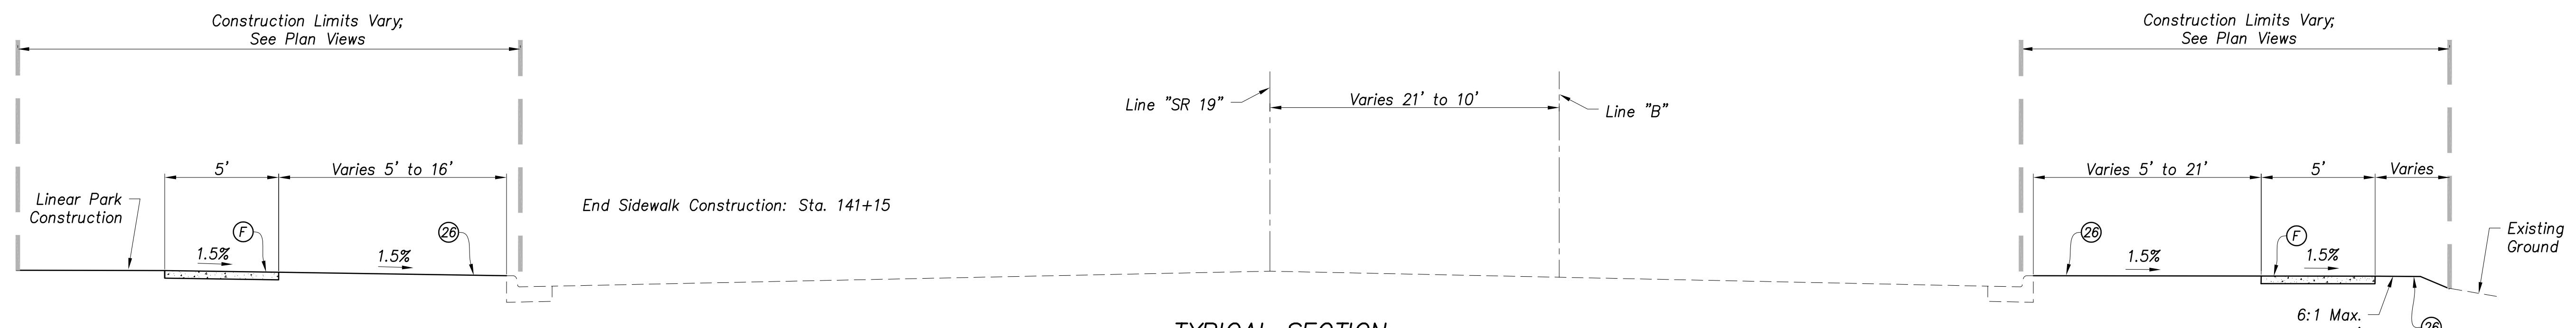

TYPICAL SECTION
Sta. 138+126 to Sta. 142+60, Line "B"
Horiz. & Vert. Scale: 1" = 4'

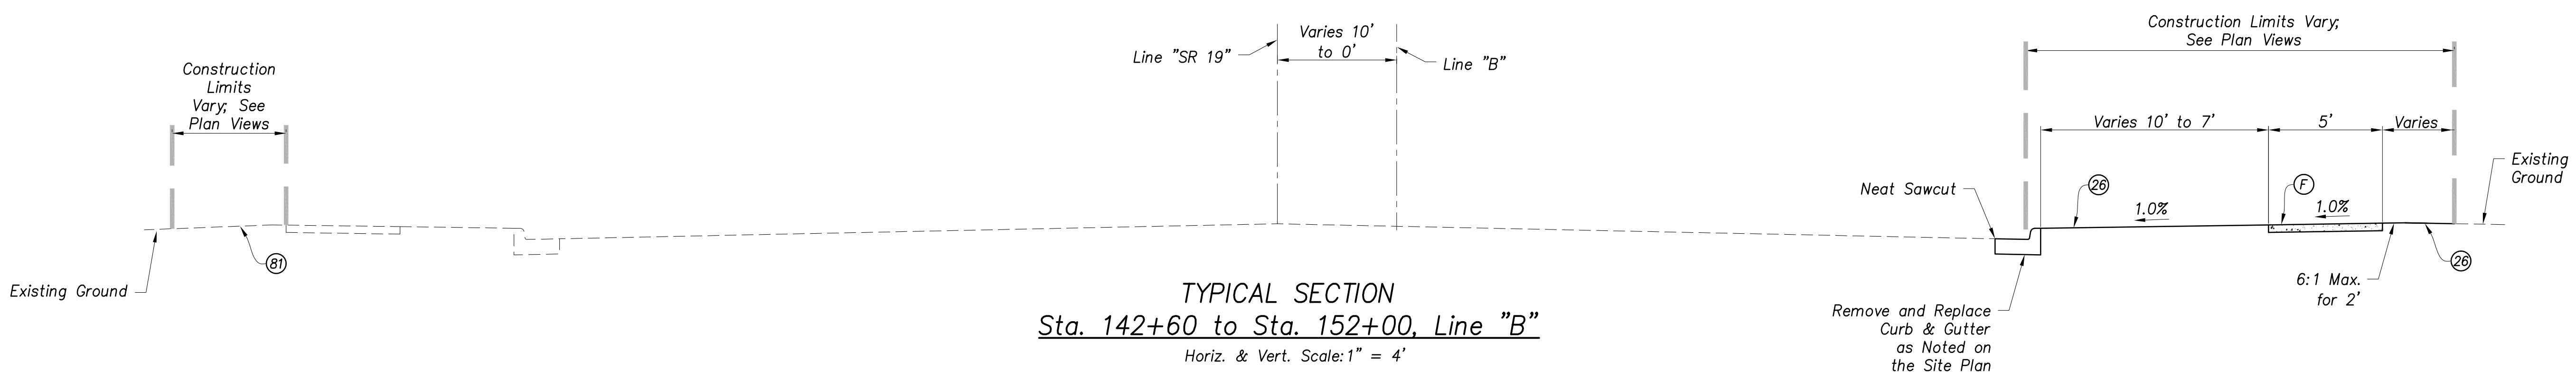

TYPICAL SECTION
Sta. 142+60 to Sta. 152+00, Line "B"
Horiz. & Vert. Scale: 1" = 4'

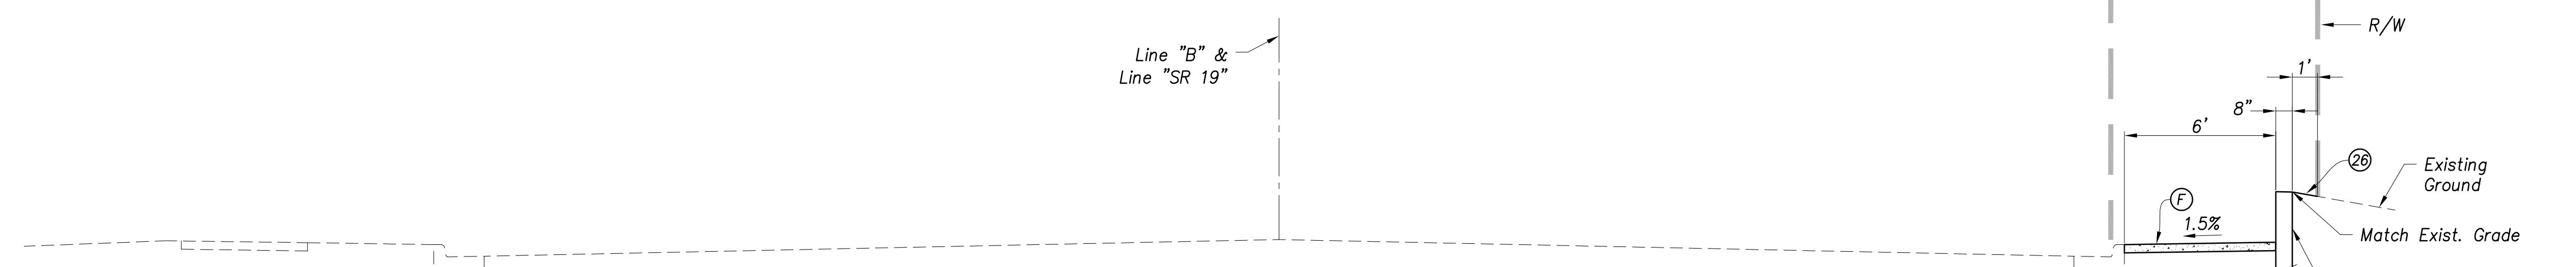

TYPICAL SECTION
Sta. 152+00 to Sta. 154+18, Line "B"

LEGEND

- Legend

 - (F) Concrete Sidewalk, 4"
 - (26) Sodding
 - (81) Mulched Seeding, Type "U"

.:

TYPICAL SECTIONS

5

DRAWN BY:
NI

DESIGNED BY:
CAK/ZDH

EM REVIEW:
RAN

QA/QC REVIEW:
DSK

DATE:
03/02/23

TEAL:




DARYL S. KNIP
REGISTERED
No. PE10000163

NATURE: Dgk

05/02/2025

CI JOB #

20-1114
HEET NO.
3 of **54**

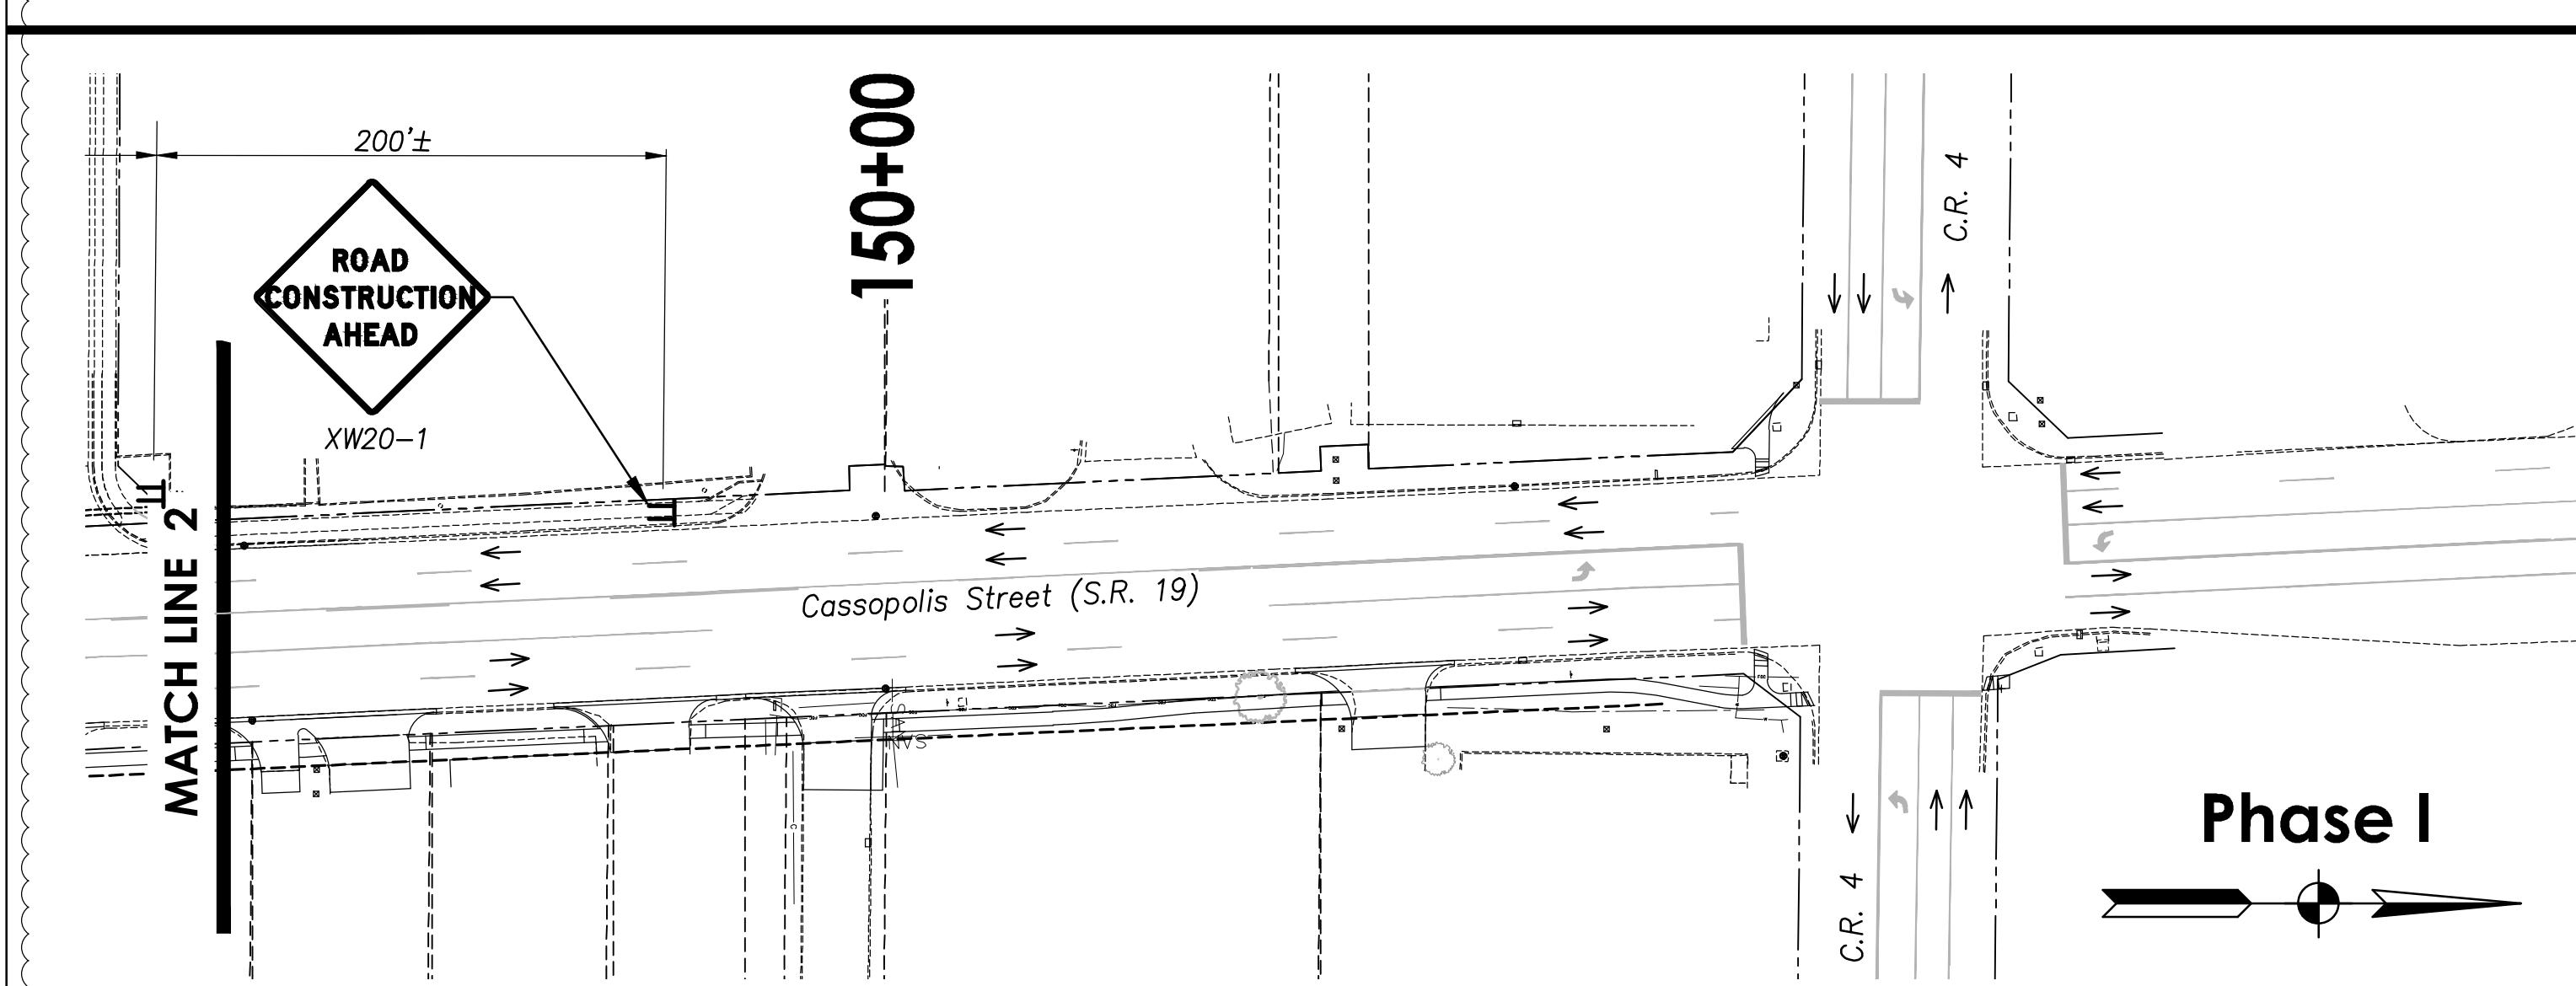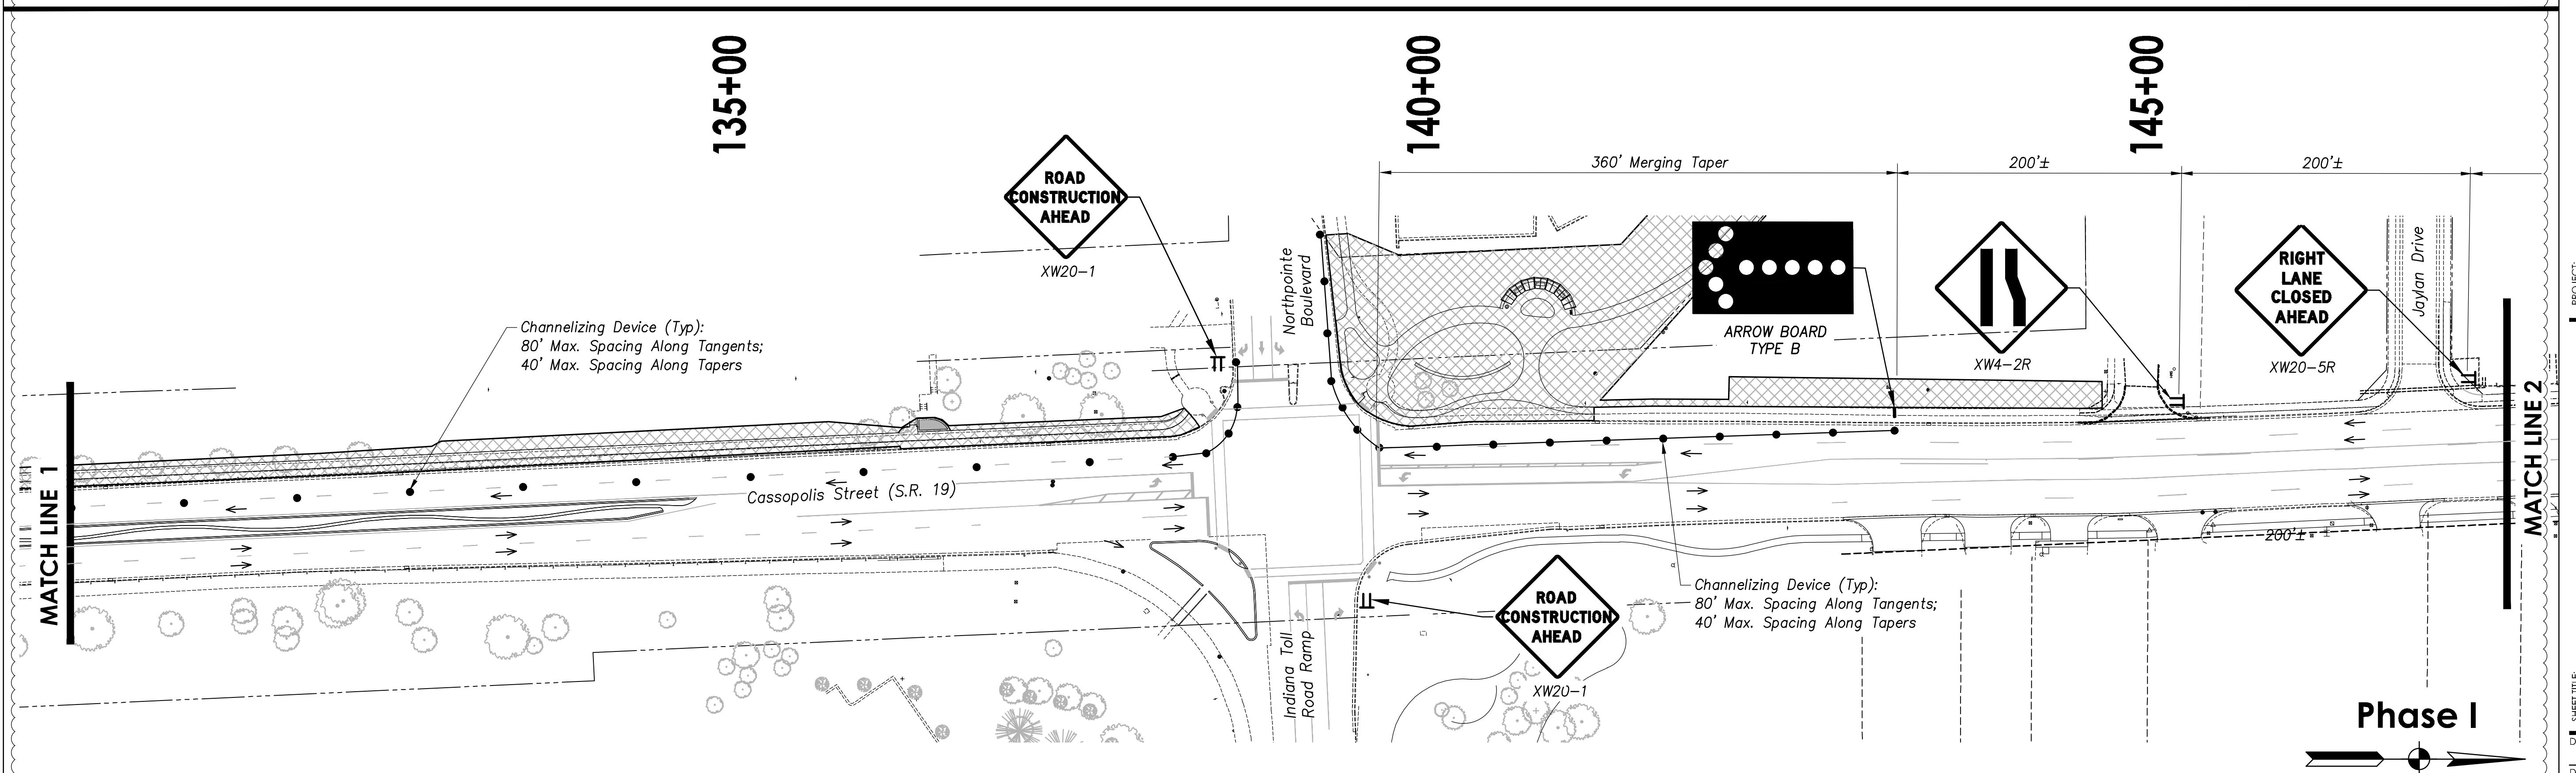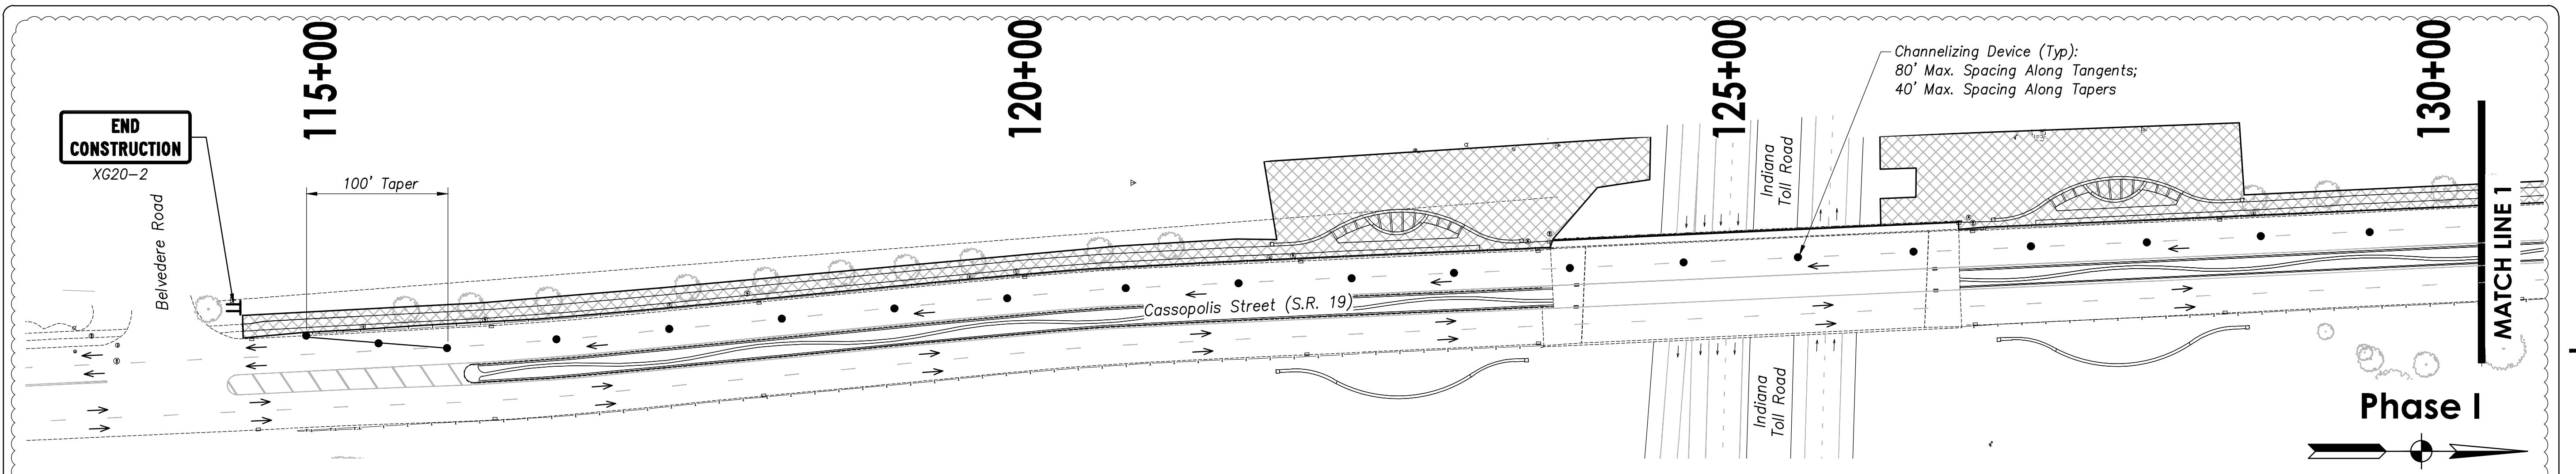

MAINTENANCE OF TRAFFIC GENERAL NOTES

- Maintenance of Traffic General Notes**

 1. All signage, traffic control devices, and striping shall be erected in accordance with Indiana MUTCD standards.
 2. Access to all properties shall be maintained at all times.
 3. Contractor shall coordinate with property owners prior to starting construction.
 4. During construction, traffic may be reduced to one lane in each direction as shown.

MAINTENANCE OF TRAFFIC: PHASE I

MAINTENANCE OF TRAFFIC: PHASE I
Phase I work to include the construction of the new sidewalk, landscaping, Placemaking Nodes 1, 3, 5 and the Linear Park on the west side of S.R. 19. Southbound lane closure from north of Belvedere Road to south of Northpointe Boulevard. Maintain access to Belvedere Road.

LEGEND

-  Construction Sign
 -  Channelizing Device
 -  Work Area
 -  Direction of Traffic

STATE ROAD 19

CORRIDOR IMPROVEMENTS

(PA7663)

1. ג'וּבָּא.

Maintenance of Traffic Phase I

DRAWN BY:	NI
DESIGNED BY:	CAK/ZDH
EM REVIEW:	RAN
DA/QC REVIEW:	DSK
DATE:	03/02/23
<p>DARYL S. KNIPPEK REGISTERED No. PEI9900163 STATE OF INDIANA PROFESSIONAL ENGINEER</p>	
SIGNATURE:	
ATE:	

03/02/2023

CALE:

HORZ: **1" = 60'**

VERT: **N/A**

CL JOB #

20-1114

HEET NO.

4 of 56

**STATE ROAD 19
CORRIDOR IMPROVEMENTS
(PA7663)**




PROJECT:

**MAINTENANCE OF TRAFFIC
PHASE II-A & PHASE II-B**

SHEET TITLE:

DRAWN BY:	NI
DESIGNED BY:	CAK/ZDH
PM REVIEW:	RAN
QA/QC REVIEW:	DSK
DATE:	03/02/23
SEAL:	DARYL S. KNAPP PROFESSIONAL ENGINEER NO. PE19900163 STATE OF INDIANA
SIGNATURE:	
DATE:	03/02/2023
SCALE:	HORZ: 1" = 60' VERT: N/A
ACI JOB #	20-1114
DATE:	May 24, 2023 8:47am

NI 5 of 56

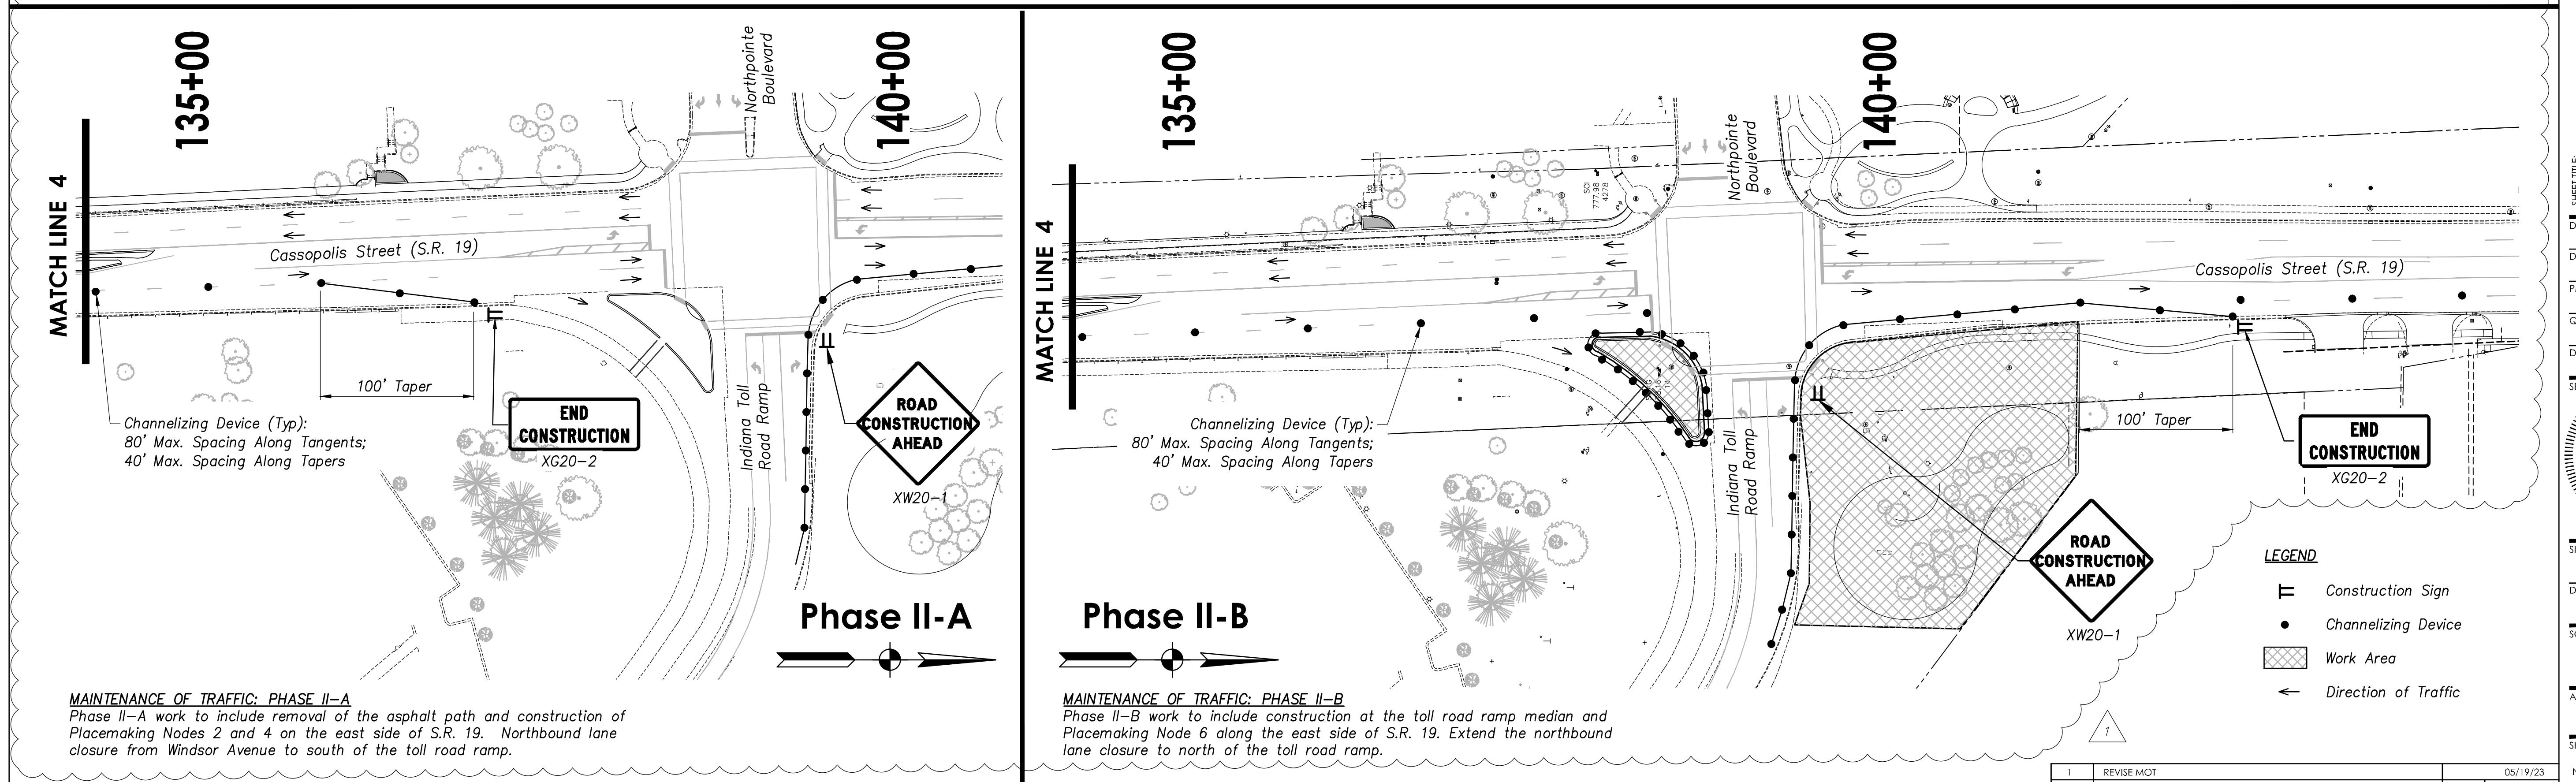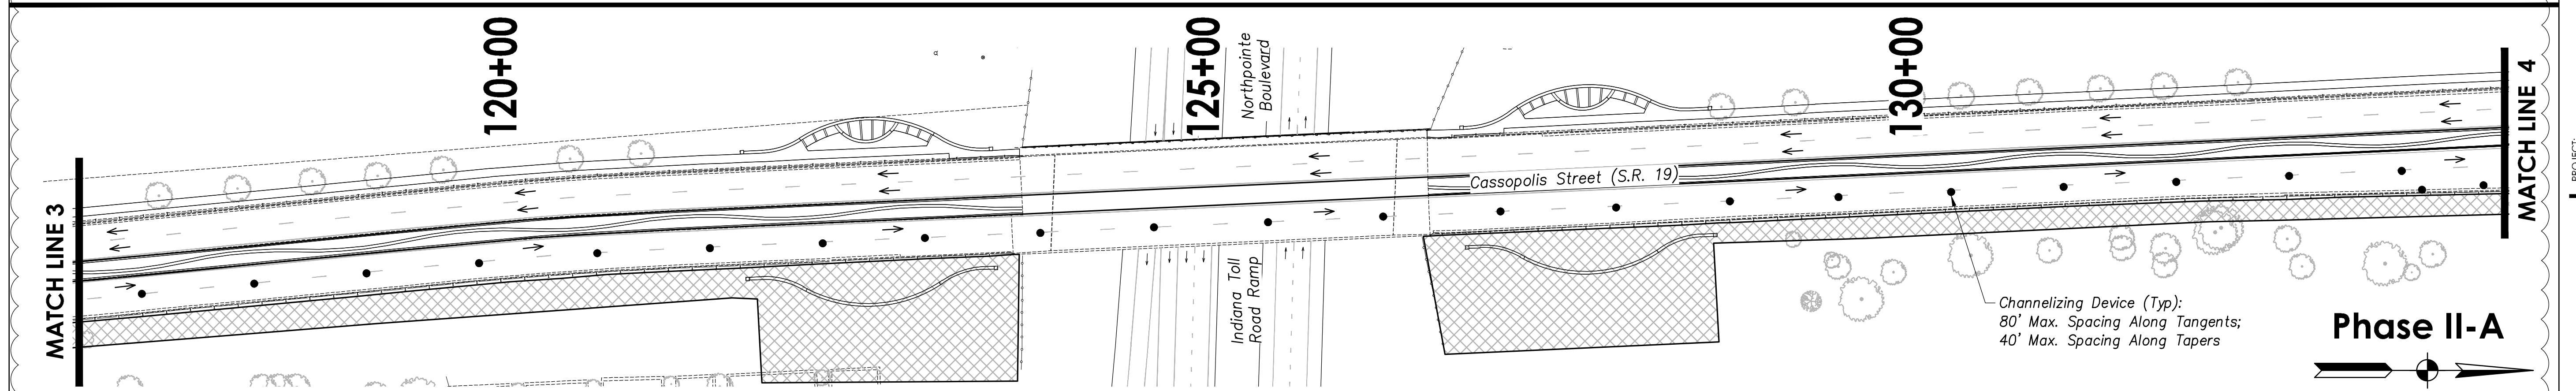
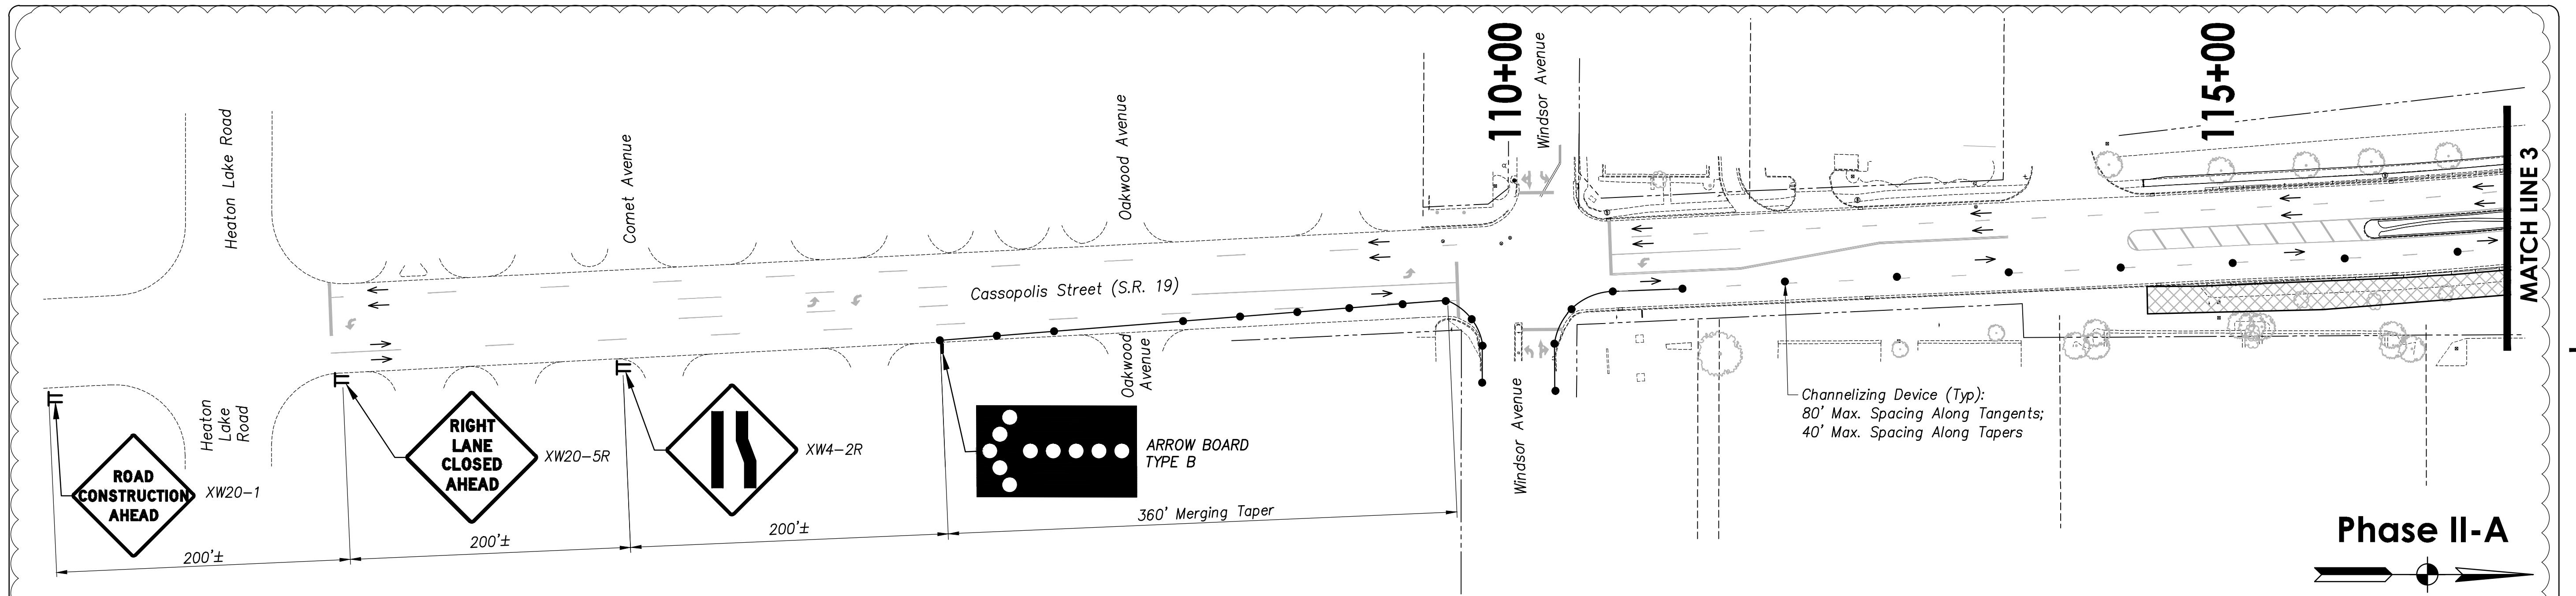


**STATE ROAD 19
CORRIDOR IMPROVEMENTS
(PA7663)**

PROJECT: Jayan Drive

**MAINTENANCE OF TRAFFIC
PHASE II-C**

SHEET TITLE: DRAWN BY: NI
DESIGNED BY: CAK/ZDH
PM REVIEW: RAN
QA/QC REVIEW: DSK
DATE: 03/02/23
SEAL: DARYL S. KNIPPEL REGISTERED PROFESSIONAL ENGINEER STATE OF INDIANA
SIGNATURE: DATE: 03/02/2023
SCALE: HORIZ: 1" = 60'
VERT: N/A
ACI JOB #: 20-1114
SHEET NO.: May 24, 2021 8:49pm
Abonmarche - May 24, 2021 8:49pm

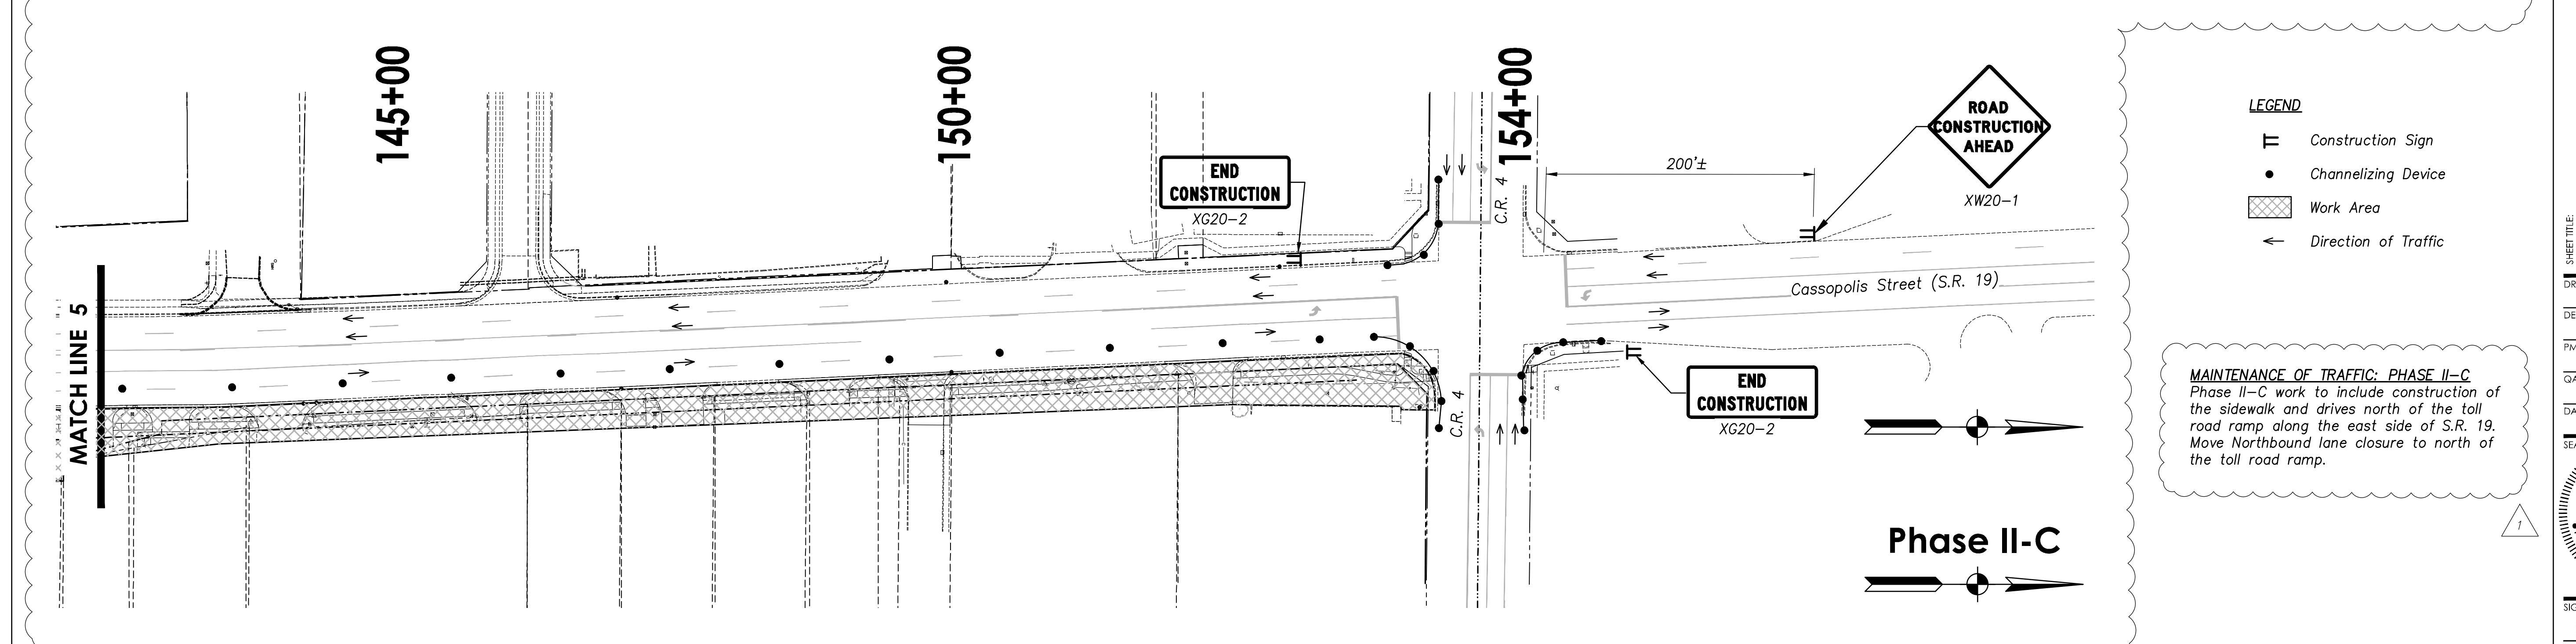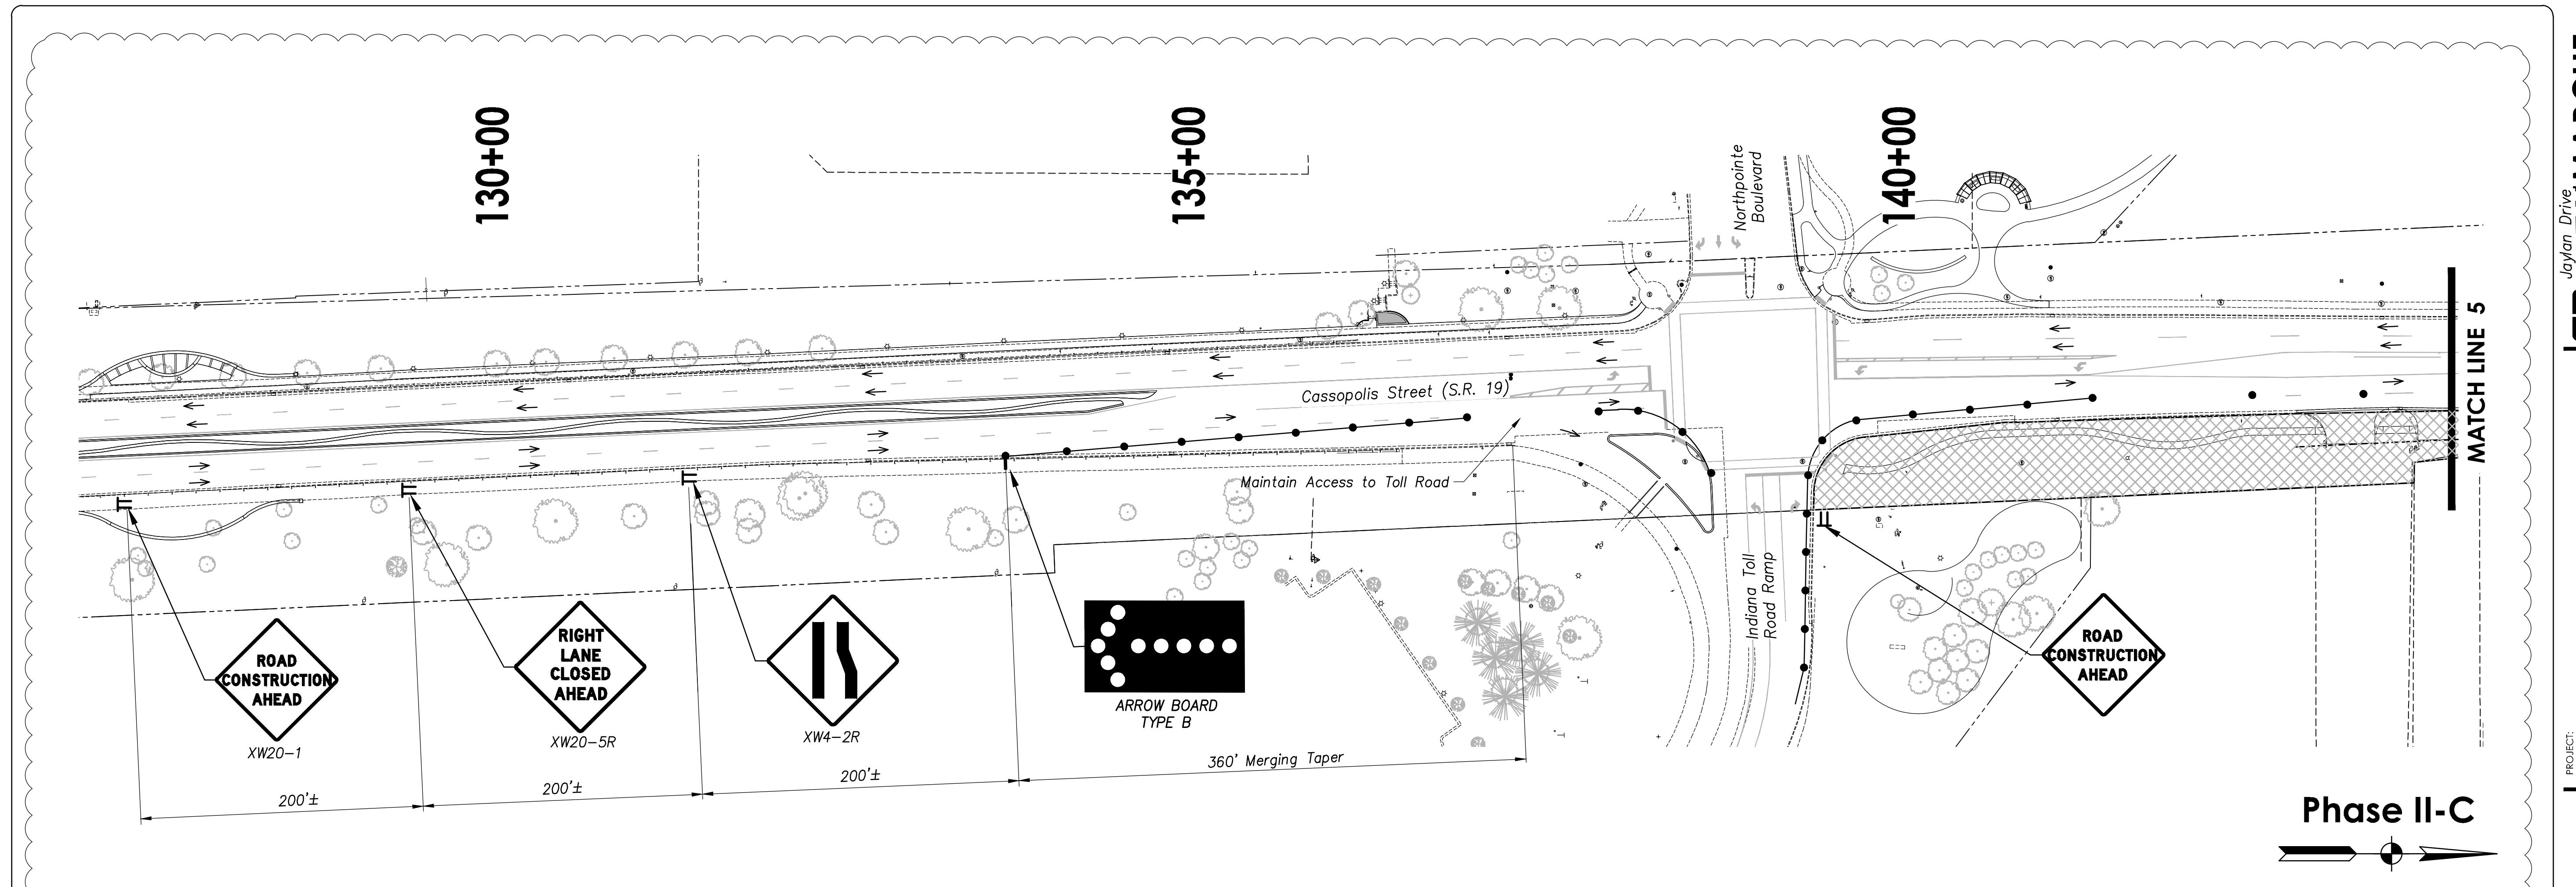

MAINTENANCE OF TRAFFIC: PHASE II-C
Phase II-C work to include construction of the sidewalk and drives north of the toll road ramp along the east side of S.R. 19. Move Northbound lane closure to north of the toll road ramp.



1.	REVISE MOT	NI	05/19/23
NO.	REVISION DESCRIPTION	BY	DATE

**STATE ROAD 19
CORRIDOR IMPROVEMENTS
(PA7663)**

PROJECT:

**MAINTENANCE OF TRAFFIC
PHASE III**

SHEET TITLE:
DRAWN BY: NI
DESIGNED BY: CAK/ZDH
PM REVIEW: RAN
QA/QC REVIEW: DSK
DATE: 03/02/23
SEAL:
DARYL S. KNAPP
REGISTERED
NO. PE19900163
STATE OF INDIANA
PROFESSIONAL ENGINEER
SIGNATURE:
DATE: 03/02/2023
SCALE: HORIZ: 1" = 60'
VERT: N/A
ACI JOB #: 20-1114
SHEET NO.: May 19, 2023 - 12:00pm
7 of 56

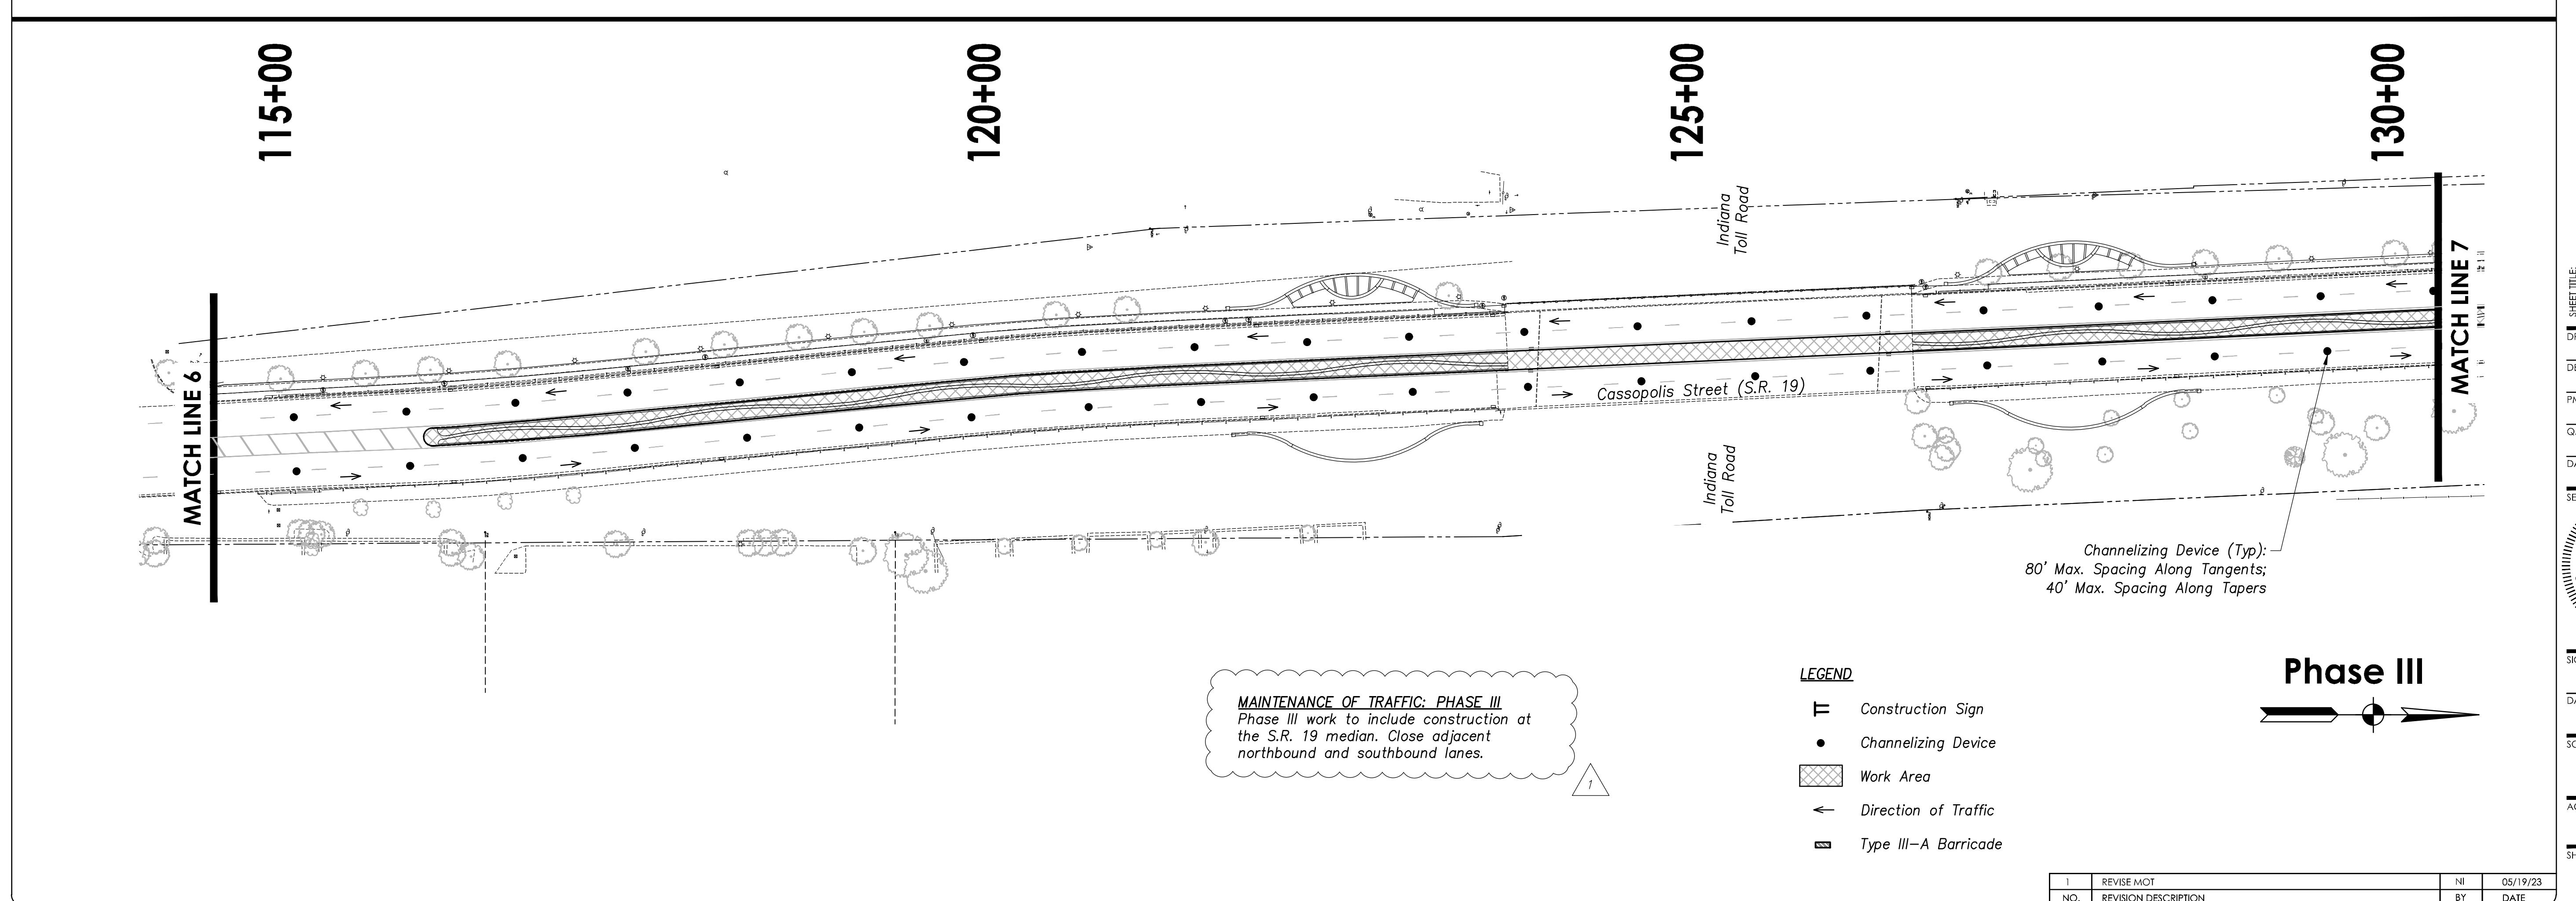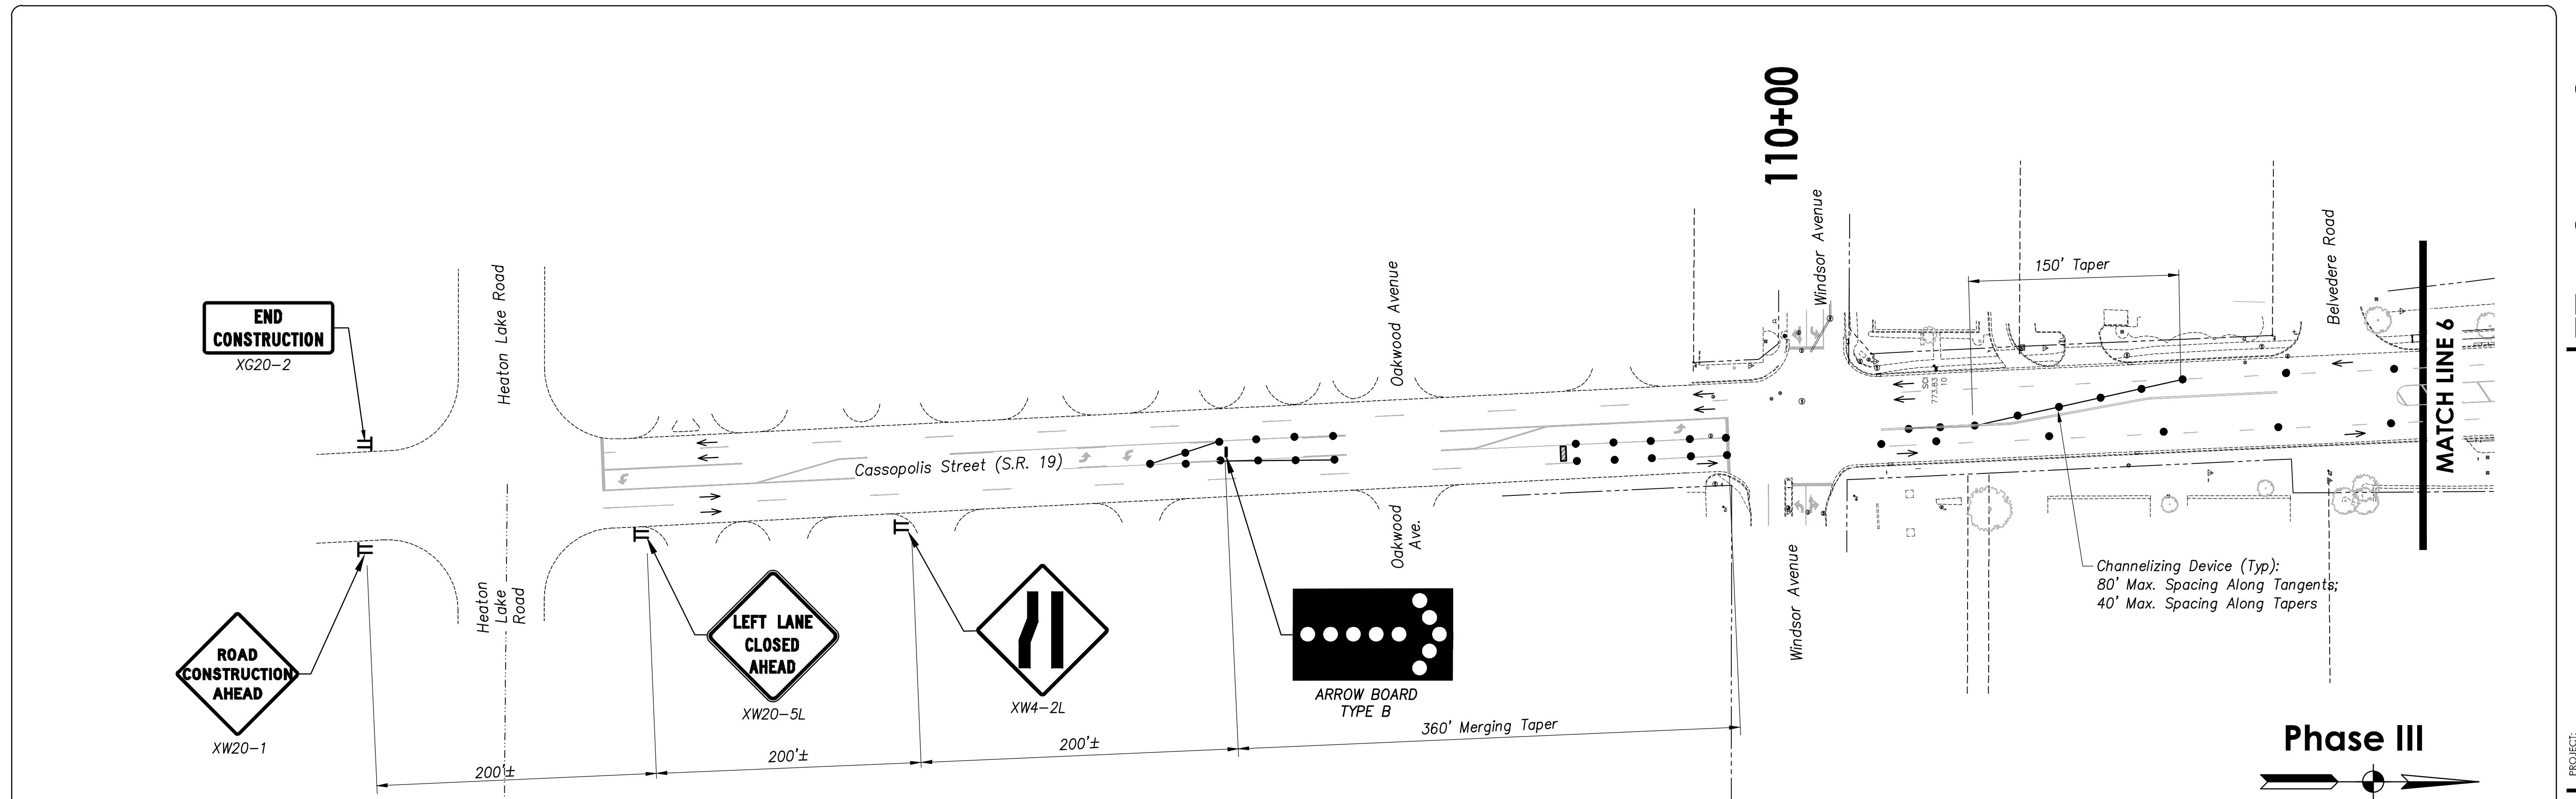


1.	REVISE MOT	NI	05/19/23
NO.	REVISION DESCRIPTION	BY	DATE


**STATE ROAD 19
CORRIDOR IMPROVEMENTS
(PA7663)**

PROJECT: STATE ROAD 19 CORRIDOR IMPROVEMENTS (PA7663)

**MAINTENANCE OF TRAFFIC
PHASE III**

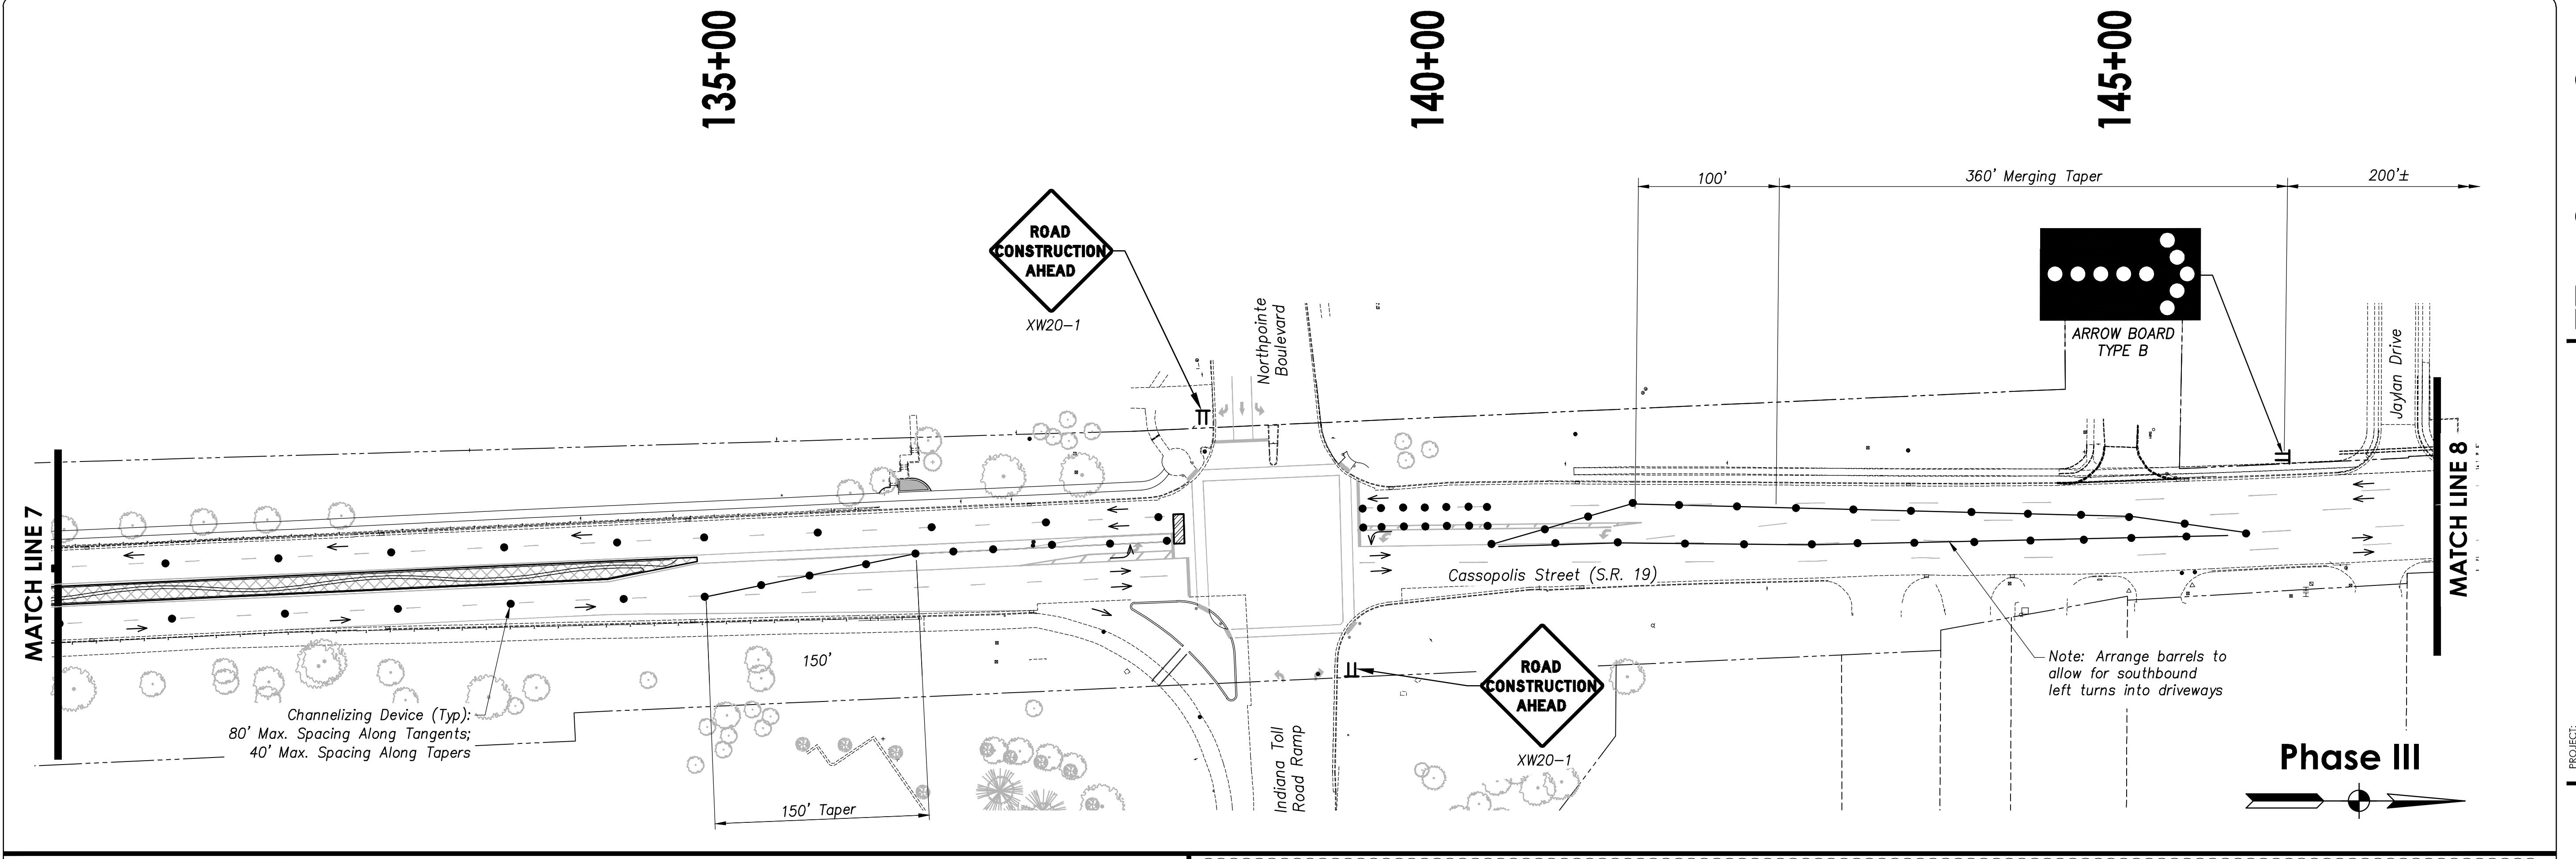

Phase III

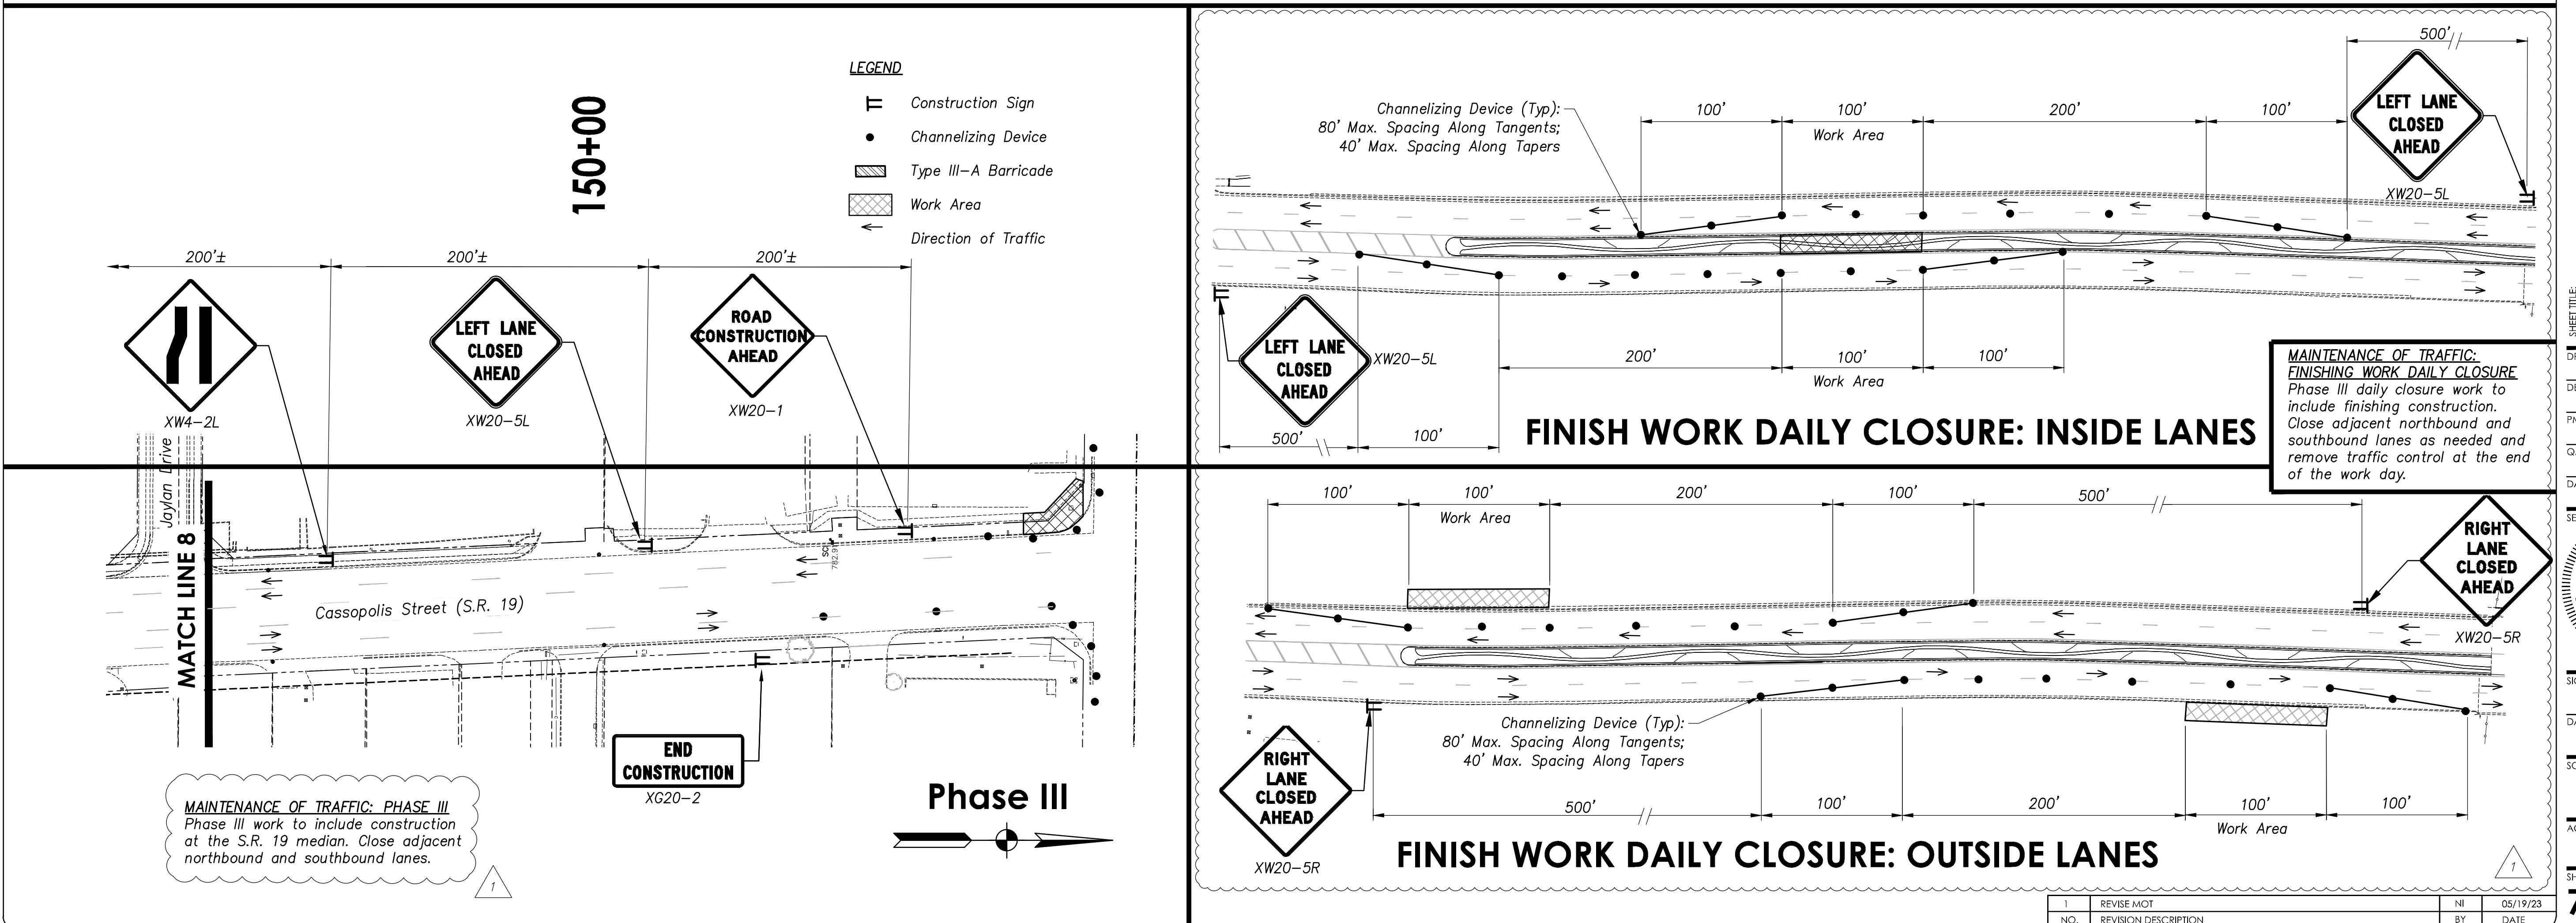

Phase III

1. REVISE MOT
NO. REVISION DESCRIPTION
NI BY DATE

05/19/23
DATE

20-1114
ACI JOB #

May 24, 2021 9:03 am

SHEET NO.

7A of 56